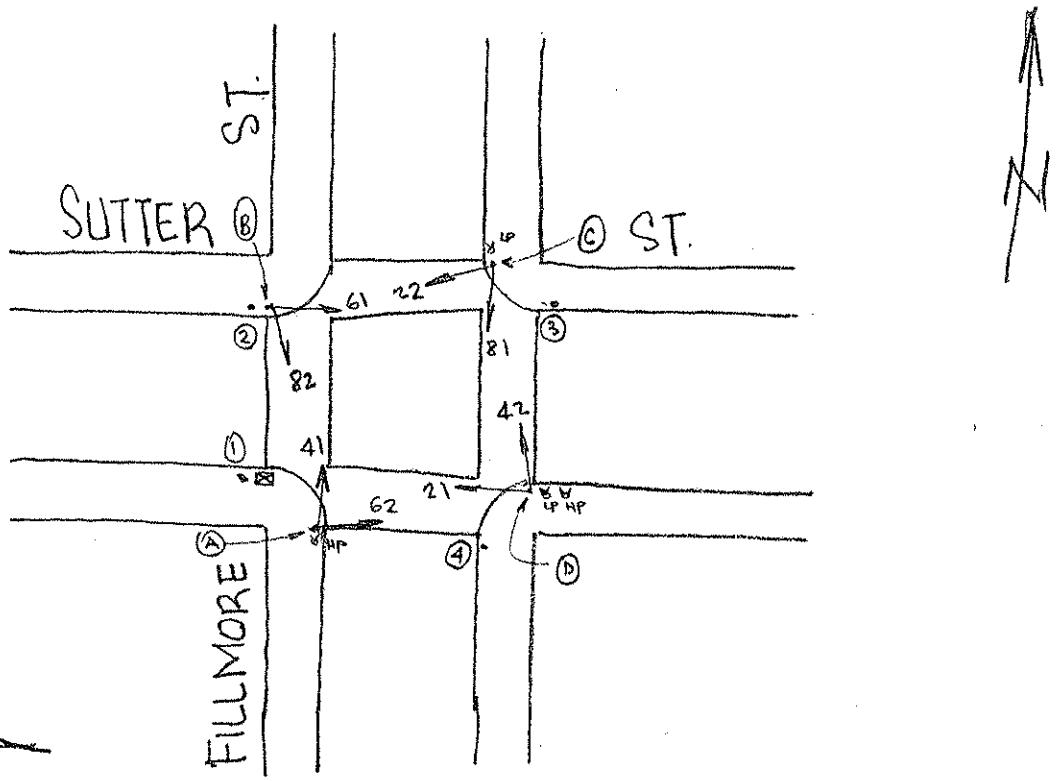

Ø2 →

6-5-79

POLE	FUNC.	MAT'L
A	M	S
B	S	S
C	L	C
D	S	S
1	M	S
2	M	S
3	M	S
4	M	S

SIGNAL NO.	MAKE	NO. OF SECT.	SIZE	VISOR	B.P. OR LOUVERS	MOUN'T
62	GA	3	8"	FL 8"	NO	S
41	GA	3	8"	FL 8"	No	S
82	EC	3	8"	FL 8"	No	T
61	EC	3	8"	FL 8"	No	T
22	EC	3	8"	FL 8"	No	S
81	EC	3	8"	FL 8"	No	S
42	EC	3	8"	FL 8"	No	T
21	EC	3	8"	FL 8"	No	T

PED SIGNAL NO.	LEGEND	MESSAGE ELEMENT	MESSAGE COLOR	MAKE	MOUN'T

CONTROLLER CABINET SIZE : ORDINARY BASE CABINET: YES

COMMENTS :