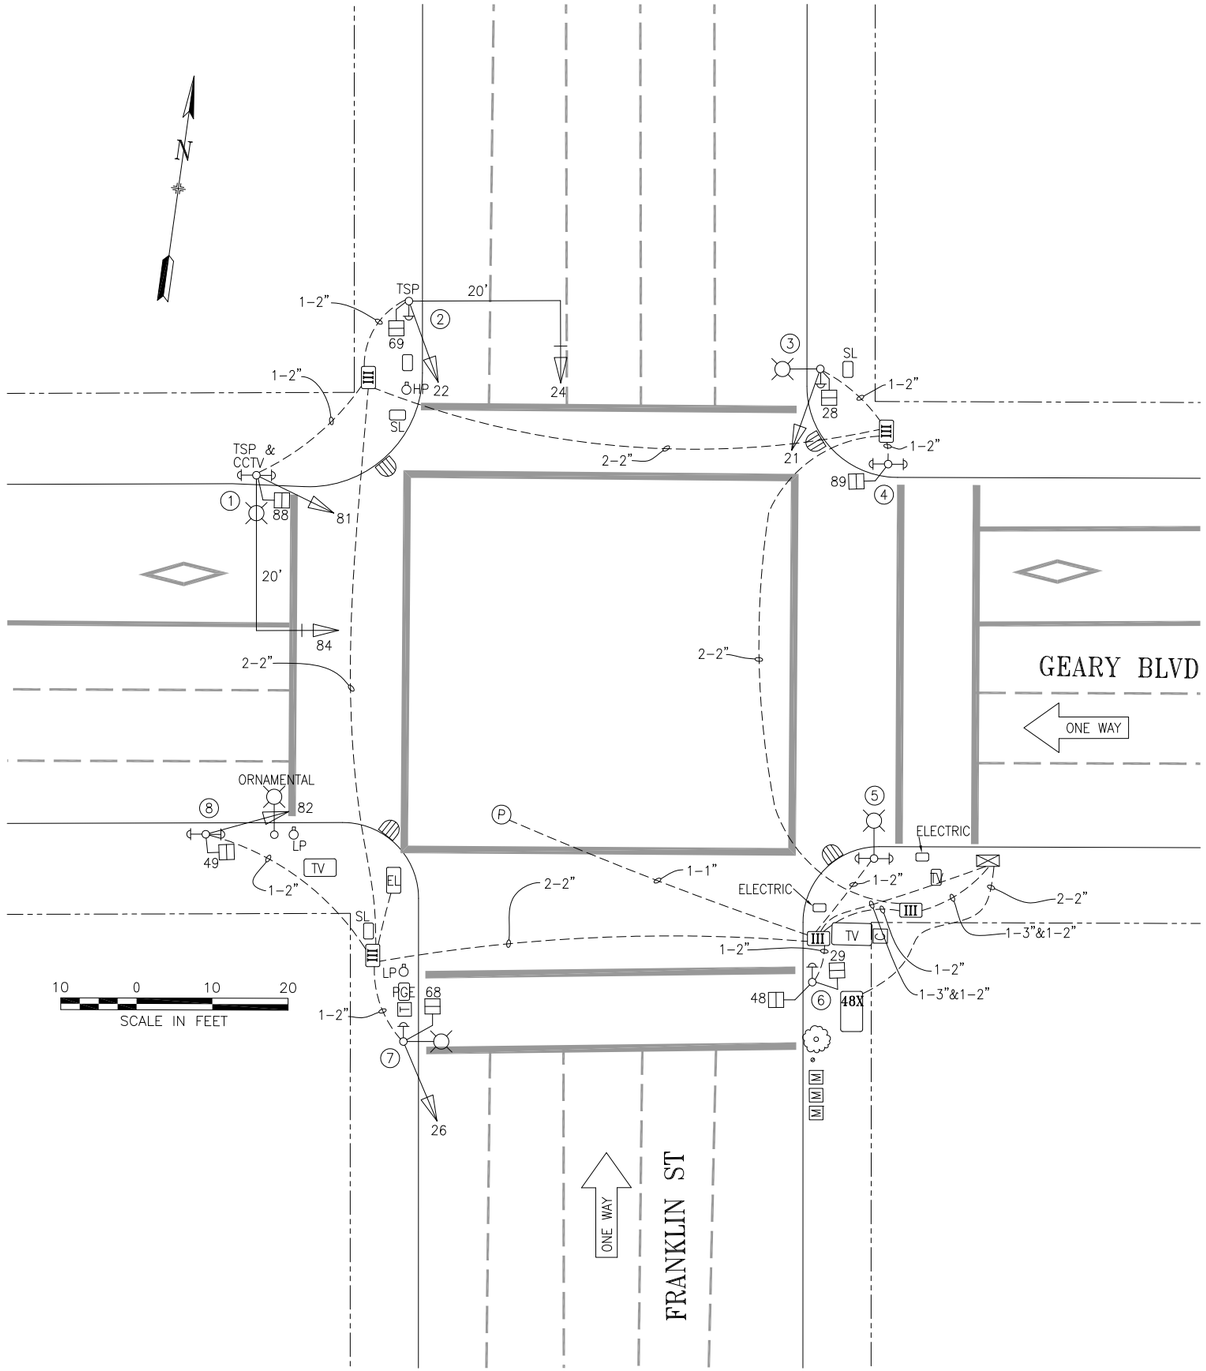

POLE AND EQUIPMENT SCHEDULE

POLE No.	TYPE OF POLE	LUMINAIRE VOLTAGE/ WATTAGE	VEHICLE SIGNAL					PEDESTRIAN SIGNAL			REMARKS
			No.	TYPE	MOUNTING	VISORS	LOUVERS	No.	TYPE	MOUNTING	
1	19-1-100 WITH 6' LUMINAIRE 20' MAST ARM		81 84	4S12"GRA 3S12"	SV-1-T MAS	T T	BACKPLATE	88	1S-COUNT	SP-1	APS (2W) X 2 TSP PROXIM CCTV
2	16-1-100 WITH 20' MAST ARM		22 24	3S12" 3S12"	SV-1-T MAS	T T	BACKPLATE	69	1S-COUNT	SP-1	APS (2W) TSP OPTICOM
3	MARBELITE STREETLIGHT		21	3S12"	SV-1-T	T		28	1S-COUNT	SP-1	APS (2W)
4	1-A (10')							89	1S-COUNT	SP-1-SF (12")	APS (2W) X 2
5	OCTAGONAL MARBLEITE STREETLIGHT										APS (2W) X 2
6	1-A (10')							29 48	1S-COUNT 1S-COUNT	SP-1 SP-1	APS (2W)
7	CITY STANDARD STREETLIGHT		26	3S12"	SV-1-T	T		68	1S-COUNT	SP-1	APS (2W)
8	1-A (15')		82	3S12"	TV-1-T	T		49	1S-COUNT	SP-1	APS (2W) X 2

NO.	DATE	DESCRIPTION	BY	APP.
1	3/6/20	PER FIELD	DNM	MV
0	4/10/14	UPGRADE ACTIVATED THRU 2246J; CONVERTED FROM CONTRACT PLANS	JH	MV

TABLE OF REVISIONS
CHECK WITH TRACING TO SEE IF YOU HAVE LATEST REVISION

REFERENCE INFORMATION & FILE NO. OF SURVEYS

SAN FRANCISCO MUNICIPAL TRANSPORTATION AGENCY
CITY AND COUNTY OF SAN FRANCISCO

DRAWN: JH DATE: 09/2015
CHECKED: MV DATE: 09/2015

SCALE: AS SHOWN
SHEET OF SHEETS 1 OF 1

TRAFFIC SIGNAL INVENTORY DIAGRAM
FRANKLIN ST AND GEARY BLVD

CNN NO. 25213000
REV NO. 1