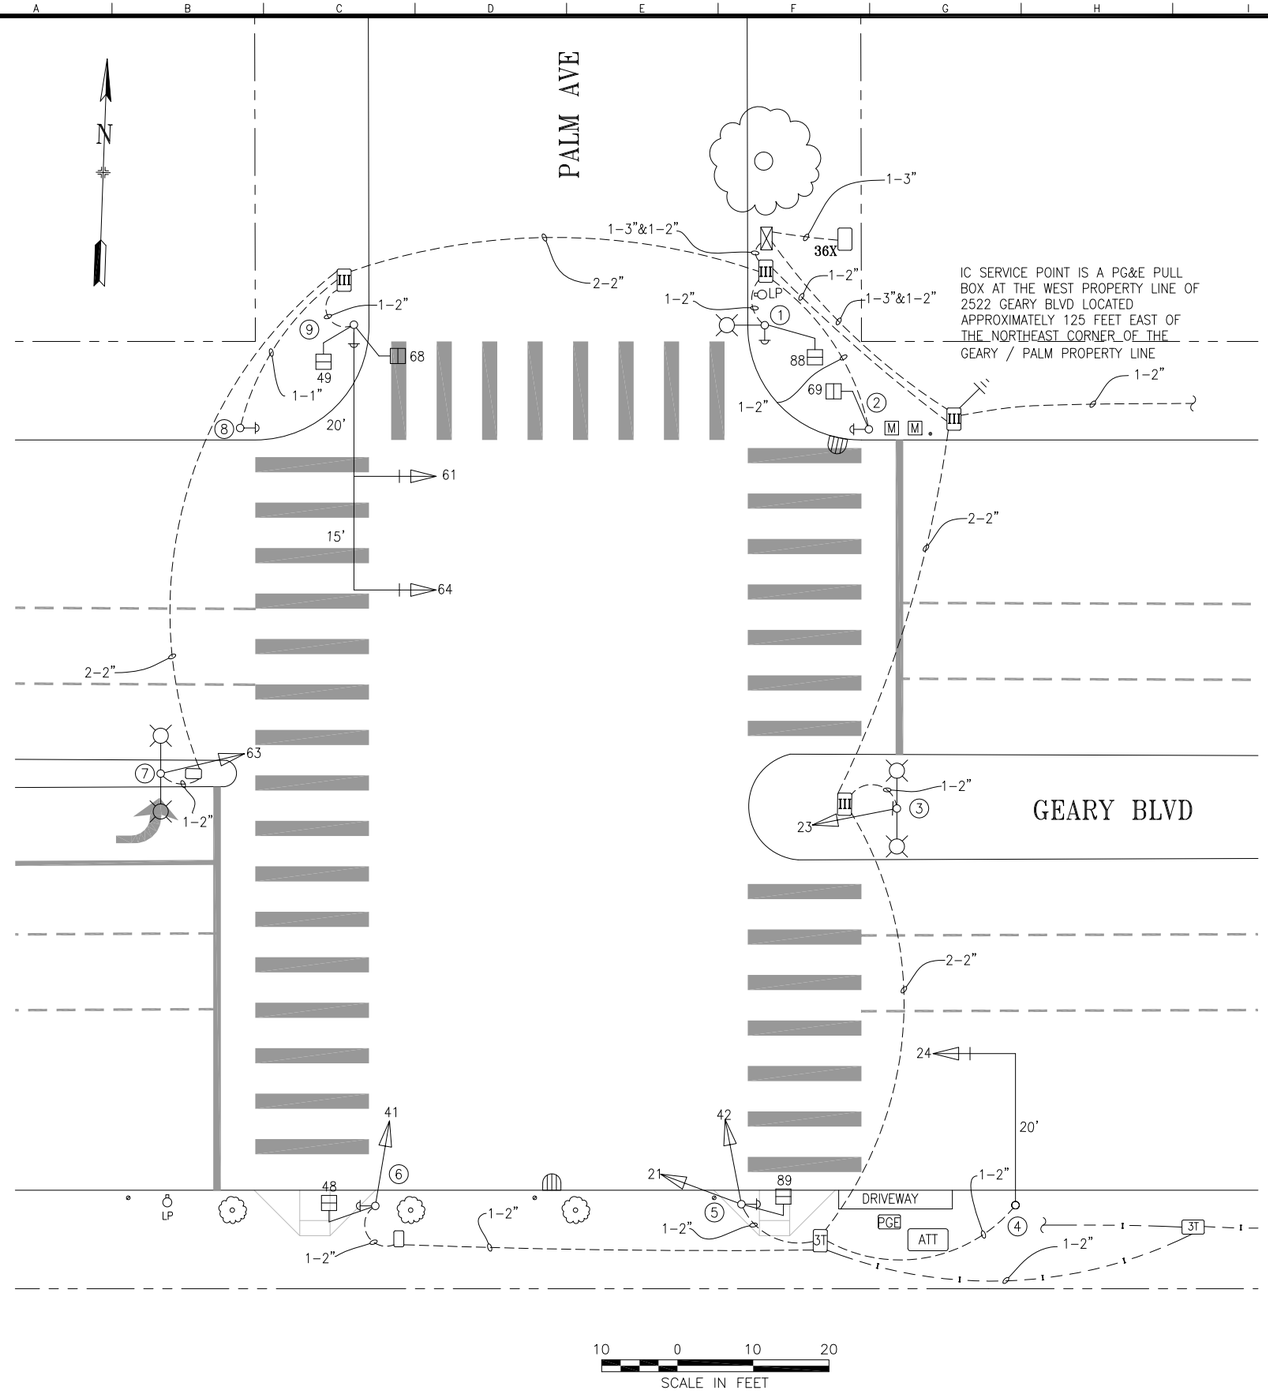

POLE AND EQUIPMENT SCHEDULE

POLE No.	TYPE OF POLE	LUMINAIRE VOLTAGE/ WATTAGE	VEHICLE SIGNAL					PEDESTRIAN SIGNAL			REMARKS
			No.	TYPE	MOUNTING	VISORS	LOUVERS	No.	TYPE	MOUNTING	
1	EX. MARBLITE STREETLIGHT							88	1S-COUNT	SP-1	APS PPB
2	1-A (7')							69	1S-COUNT	TP-1	APS PPB
3	EX. MARBLITE SL W/ DUAL LUMINARE ARMS		23	3S12"	SV-1-T	T					
4	16-2-100 WITH 20' MAST ARM		24	3S12"	MAS	T					BACKPLATE
5	1-A (13')		21 42	3S12" 3S12"	TV-2-T	T T		89	1S-COUNT	SP-1	APS PPB
6	1-A (13')		41	3S12"	TV-1-T	T		48	1S-COUNT	SP-1	APS PPB
7	EX. MARBLITE SL W/ DUAL LUMINARE ARMS		63	3S12"	SV-1	T					EXTERNAL CONDUIT
8	PPB POLE										APS PPB
9	23-3-100 WITH 35' MAST ARM		61 64	3S12" 3S12"	MAS MAS	T T		49 68	1S-COUNT 1S-COUNT	SP-1 (22") SP-1-SF	BACKPLATE BACKPLATE APS PPB

NO.	DATE	DESCRIPTION	BY	APP.
0	10/9/14	ACTIVATED THRU 2246J; CONVERTED FROM CONTRACT PLANS	JH	MV

TABLE OF REVISIONS
CHECK WITH TRACING TO SEE IF YOU HAVE LATEST REVISION

REFERENCE INFORMATION & FILE NO. OF SURVEYS

SAN FRANCISCO MUNICIPAL TRANSPORTATION AGENCY
CITY AND COUNTY OF SAN FRANCISCO

DRAWN: JH DATE: 08/15
CHECKED: MV DATE: 08/15

SCALE: AS SHOWN
SHEET OF SHEETS 1 OF 1

TRAFFIC SIGNAL INVENTORY DIAGRAM
GEARY BOULEVARD AND PALM AVENUE

CNN NO. 27229000
REV NO. 0