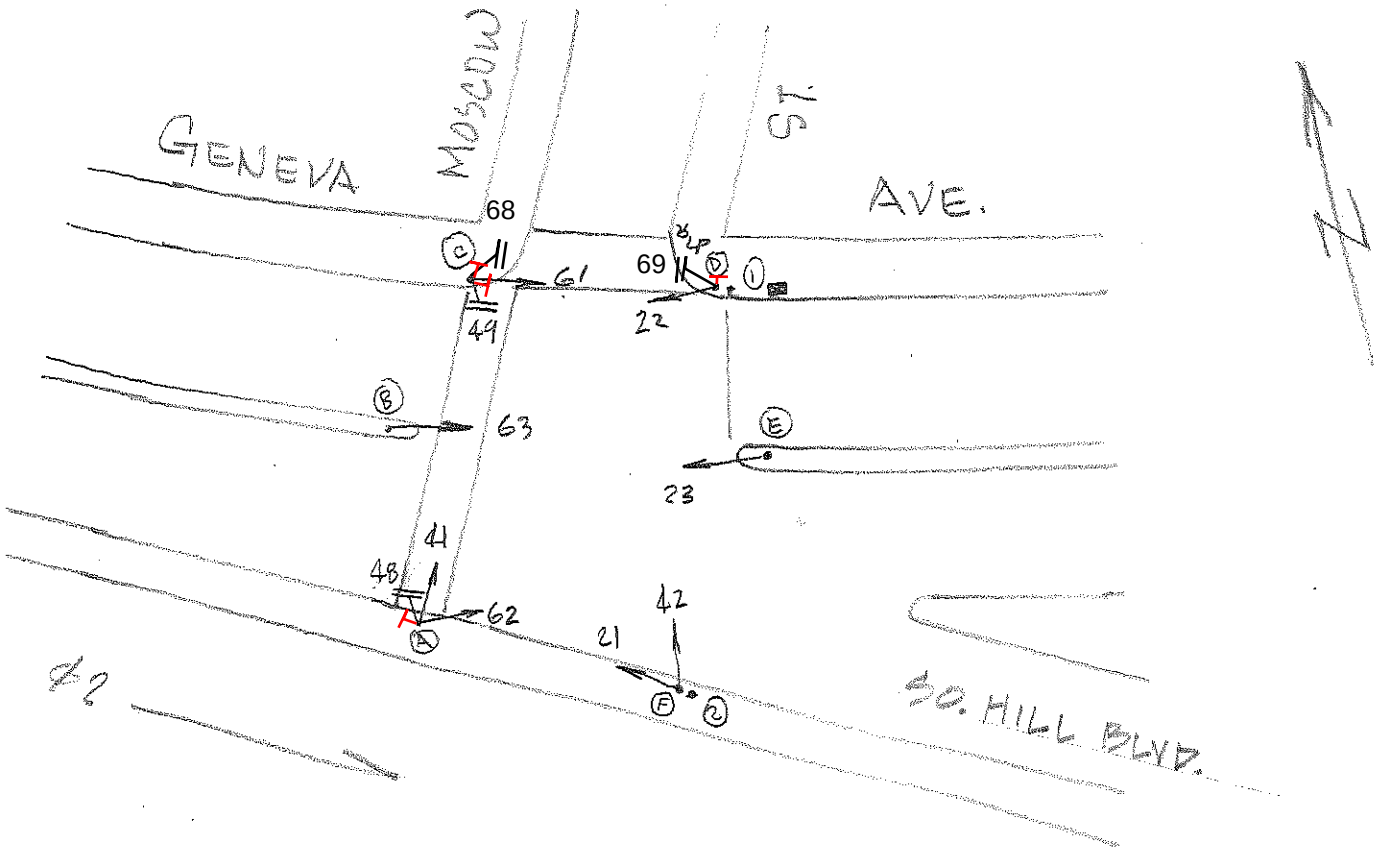

10/26/2022

POLE	FUNC.	MAT'L
A	S	S
B	L	S
C	S	S
D	S	S
E	L	S
F	S	S
1	U	W
2	U	W

SIGNAL NO.	MAKE	NO. OF SECT.	SIZE	VISOR	B.P. OR LOUVERS	MOUN'T
62	EC	3	12"	T 12"	No	
41	EC	3	12"	T 12"	No	TV-2-T-SFA
63	EC	3	12"	T 12"	No	S
61	EC	3	12"	T 12"	No	T
22	EC	3	12"	T 12"	No	TV-1-T
23	EC	3	12"	T 12"	No	S
21	EC	3	12"	T 12"	NO	
42	EC	3	12"	T 12"	NO	TV-2-T-SFA

PED SIGNAL NO.	LEGEND	MESSAGE ELEMENT	MESSAGE COLOR	MAKE	MOUN'T
48		1S-C			S
49		1S-C			S
68		1S-C			S
69		1S-C			S

CONTROLLER CABINET SIZE : ORDINARY BASE CABINET: YES

COMMENTS : PER SRC 2022-218: UPGRADE 21,22,41,42 & 62 TO 12-INCH & ADD 3-WIRE APS

- D. Yeung