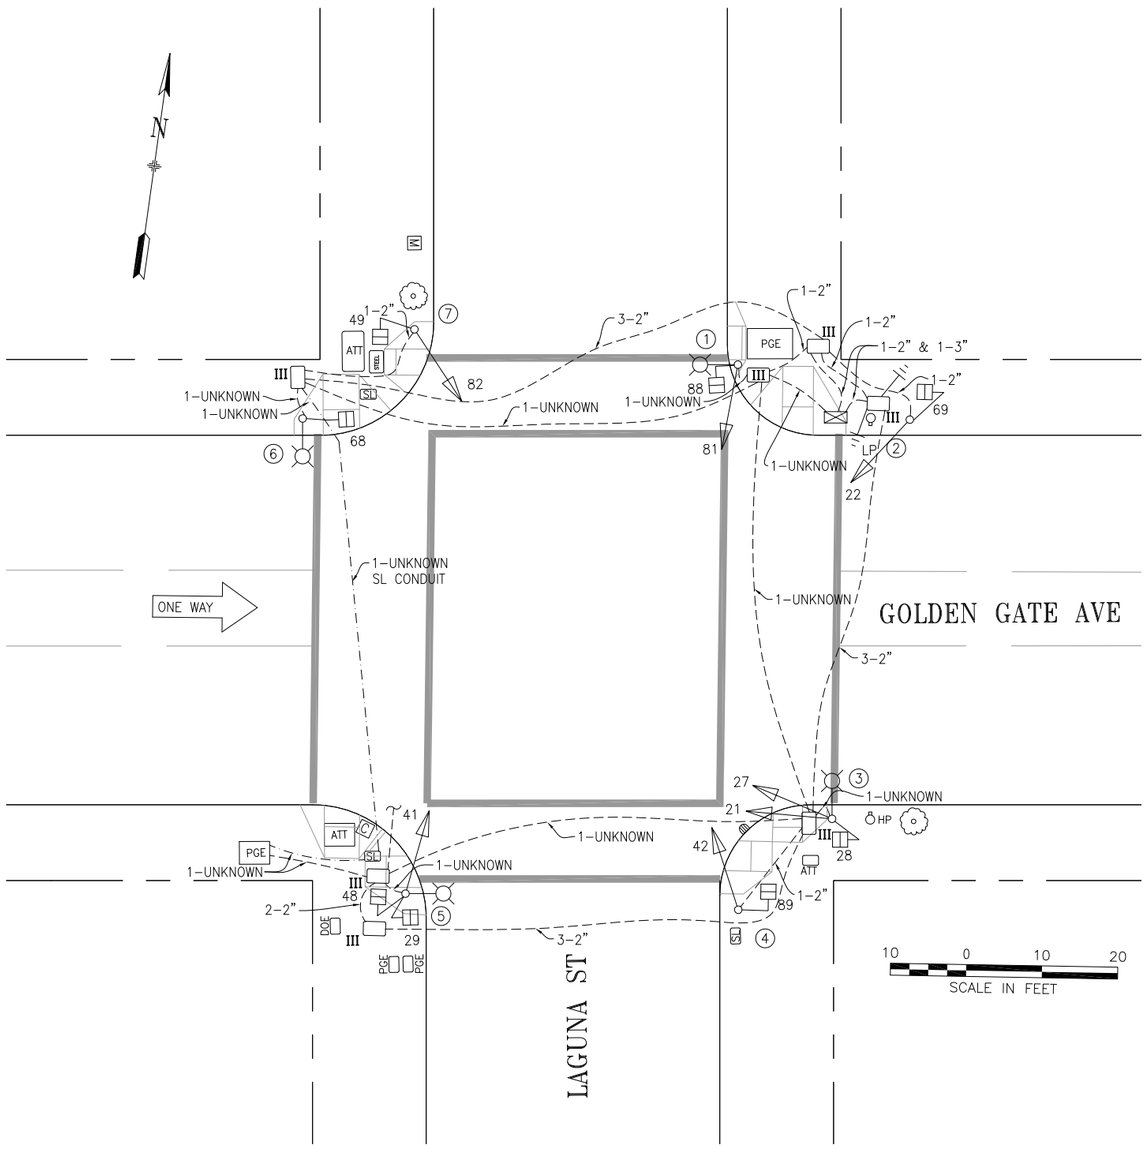

NOTE: CABINET FOUNDATION TYPE: M-SF ON ADAPTER PLATE

POLE AND EQUIPMENT SCHEDULE

POLE No.	TYPE OF POLE	LUMINAIRE VOLTAGE/ WATTAGE	VEHICLE SIGNAL					PEDESTRIAN SIGNAL			REMARKS
			No.	TYPE	MOUNTING	VISORS	LOUVERS	No.	TYPE	MOUNTING	
1	MARBELITE SL		81	3S12"	SV-1-T	T		88	1S-COUNT	SP-1	
2	1-A (10')		22	3S12"	TV-1-T	T		69	1S-COUNT	SP-1	
3	MARBELITE SL		21 27	3S12" 3S12"	SV-1 SV-1-T(36")	T T		28	1S-COUNT	SP-1	27 AT 15' HIGH
4	1-A (10')		42	3S12"	TV-1-T	T		89	1S-COUNT	SP-1	
5	MARBELITE SL		41	3S12"	SV-1-T	T		29 48	1S-COUNT 1S-COUNT	SP-1 SP-1	
6	MARBELITE SL							68	1S-COUNT	SP-1	
7	1-A (10')		82	3S12"	TV-1-T	T		49	1S-COUNT	SP-1	

NO.	DATE	DESCRIPTION	BY	APP.
0	11/15/17	POLES AND CONDUITS VIA 2821J/SIGNALS VIA SRC 2016-300	D.YEUNG	G.DELEON

TABLE OF REVISIONS
CHECK WITH TRACING TO SEE IF YOU HAVE LATEST REVISION

REFERENCE INFORMATION & FILE NO. OF SURVEYS

SAN FRANCISCO MUNICIPAL TRANSPORTATION AGENCY
CITY AND COUNTY OF SAN FRANCISCO

DRAWN: DYeung DATE: 12/21/17
CHECKED: GDeLeon DATE: 12/21/17

SCALE: AS SHOWN
SHEET OF SHEETS: 1 OF 1

TRAFFIC SIGNAL INVENTORY DIAGRAM
GOLDEN GATE AVENUE AND LAGUNA STREET

CNN NO. 25959000
REV NO. 0