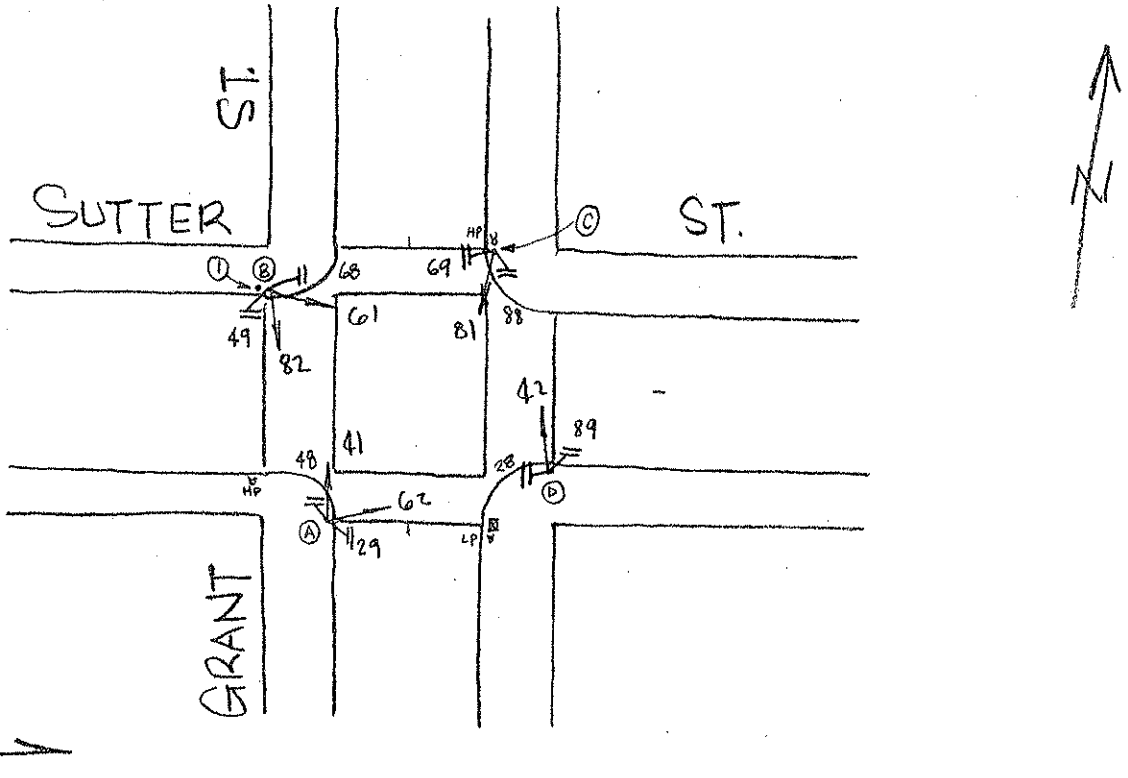

$\phi 2$ →

8-22-79

POLE	FUNC.	MAT'L
A	S	S
B	S	S
C	S	S
D	L	O
1	M	S

SIGNAL NO.	MAKE	NO. OF SECT.	SIZE	VISOR	B.P. OR LOUVERS	MOUN'T
62	EC	3	8"	FC 8"	NO	T
41	EC	3	8"	FC 8"	NO	T
82	EC	3	8"	FC 8"	NO	T
61	EC	3	8"	FC 8"	NO	T
81	EC	3	8"	FC 8"	NO	T
42	EC	3	8"	FC 8"	NO	S

PED SIGNAL NO.	LEGEND	MESSAGE ELEMENT	MESSAGE COLOR	MAKE	MOUN'T
29	W/DW	GRD	W/OR	ED	S
48	W/DW	GRD	W/OR	ED	S
49	W/DW	GRD	W/OR	ED	S
68	W/DW	GRD	W/OR	ED	S
69	W/DW	GRD	W/OR	ED	S
88	W/DW	GRD	W/OR	ED	S
89	W/DW	GRD	W/OR	ED	S
28	W/DW	GRD	W/OR	ED	S

CONTROLLER CABINET SIZE : ORDINARY BASE CABINET: NO

COMMENTS :