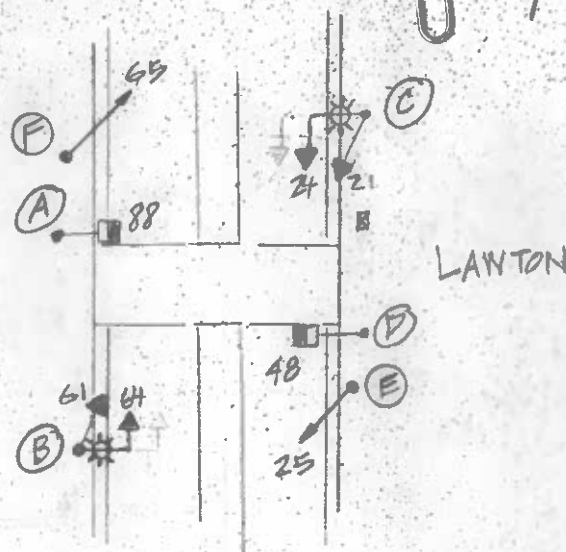


[illegible]

- J. Hornbostel