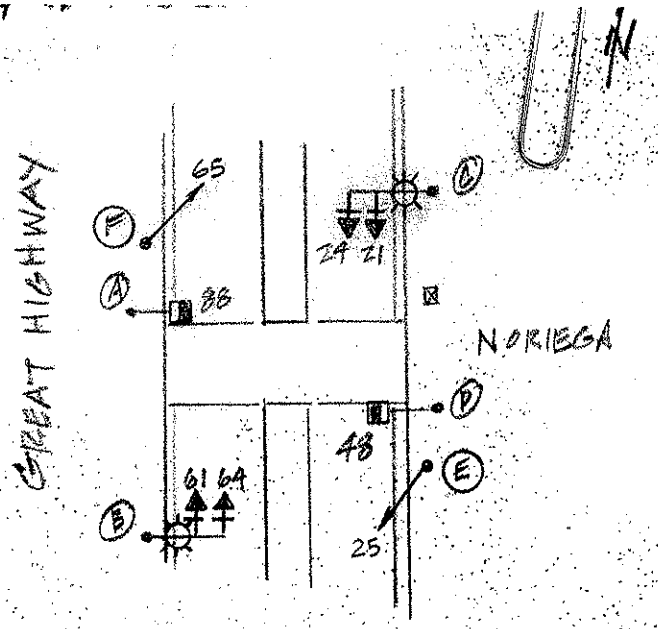

11/5/03

POLE	FUNC.	MAT'L	SIGNAL NO.	MAKE	NO. OF SECT.	SIZE	VISOR	B.P. OR LOUVERS	MOUN'T	PED SIGNAL NO.	LEGEND	MESSAGE ELEMENT	MESSAGE COLOR	MAKE	MOUN
A	S	S	61	EC	3	12"	FC 12"	–	MAS	88	I	1S-1	W/O	ICC	T
B	L	S	64	EC	3	12"	FC 12"	–	MAS	48	I	1S-1	W/O	ICC	T
C	L	S	24	EC	3	12"	FC 12"	–	MAS						
D	S	S	21	EC	3	12"	FC 12"	–	MAS						
E	L	C	25	EC	3	8"	FC 8"	–	S						
F	L	C	65	EC	3	8"	FC 8"	–	S						

CONTROLLER CABINET SIZE : Ordinary BASE CABINET : No

COMMENTS :