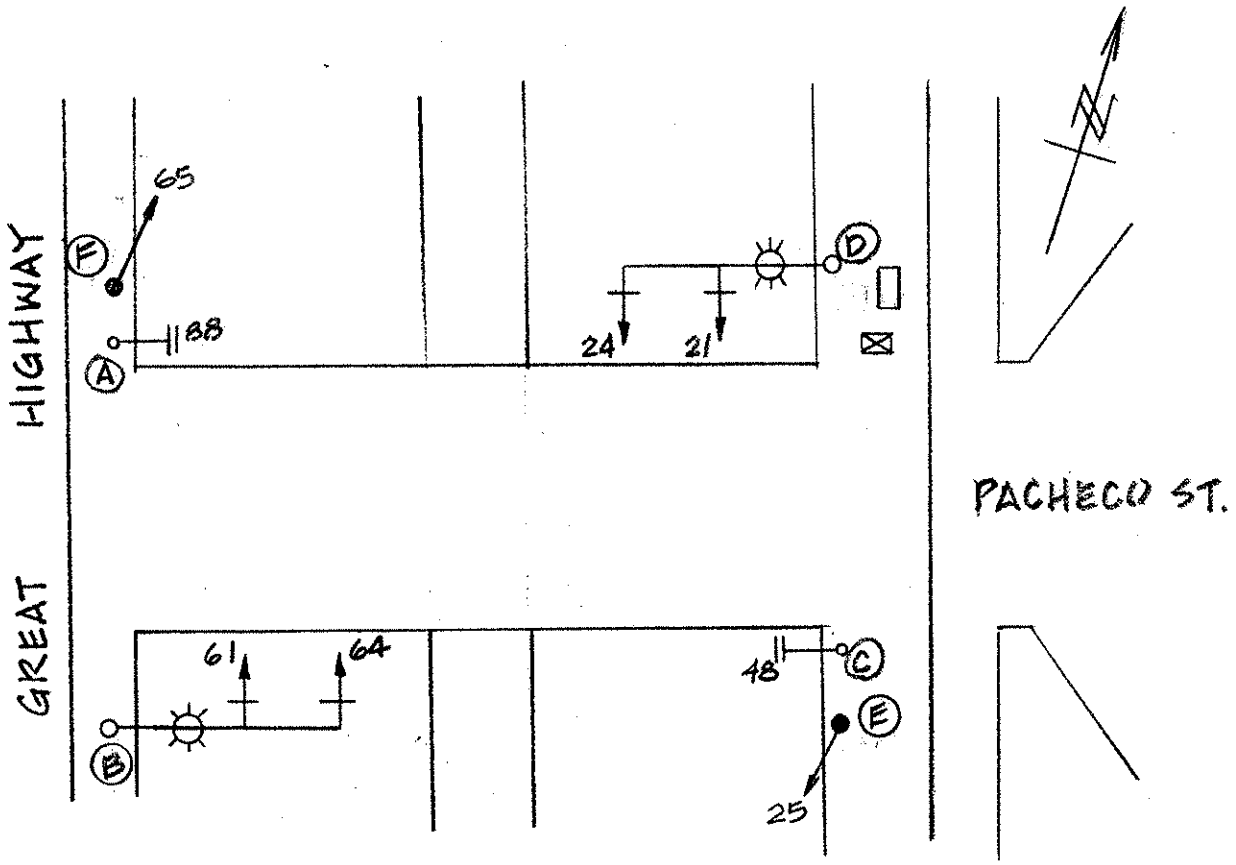

11/5/03

POLE	FUNC.	MAT'L	SIGNAL NO.	MAKE	NO. OF SECT.	SIZE	VISOR	B.P. OR LOUVERS	MOUN'T
A	S	S	61	EC	3	12"	FC 12"	—	MAS
B	L	S	64	EC	3	12"	FC 12"	—	MAS
C	S	S	21	EC	3	12"	FC 12"	—	MAS
D	L	S	24	EC	3	12"	FC 12"	—	MAS
E	L	C	25	EC	3	8"	FC 8"	—	S
F	L	C	65	EC	3	8"	FC 8"	—	S

PED SIGNAL NO.	LEGEND	MESSAGE ELEMENT	MESSAGE COLOR	MAKE	MOUN'T
88	I	15-1	W/O	ICC	T
48	I	15-1	W/O	ICC	T

CONTROLLER CABINET SIZE : _____ BASE CABINET: _____