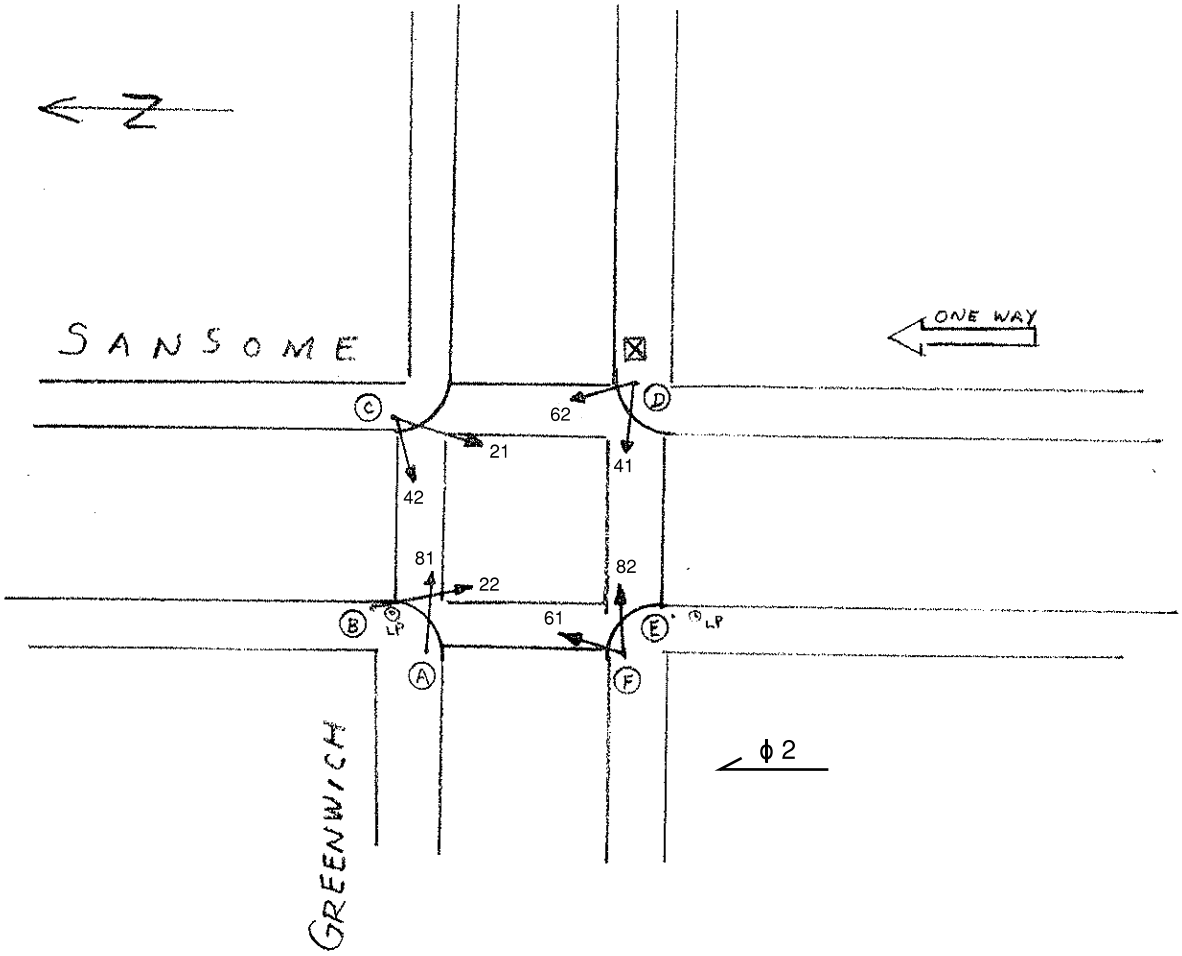

11-29-2022

POLE	FUNC.	MAT'L
A	S	S
B	S	S
C	L	S
D	L	S
E	L	S
F	S	S

SIGNAL NO.	MAKE	NO. OF SECT.	SIZE	VISOR	B.P. OR LOUVERS	MOUN'T
81	EC	3	8"	FC 8"	No	T
22	EC	3	8"	FC 8"	No	T
42	EC	3	8"	FC 8"	No	S
21	EC	3	8"	FC 8"	No	S
62	EC	3	8"	FC 8"	No	S
41	EC	3	8"	FC 8"	No	S
82	EC	3	8"	FC 8"	No	T
61	EC	3	8"	FC 8"	No	T

PED SIGNAL NO.	LEGEND	MESSAGE ELEMENT	MESSAGE COLOR	MAKE	MOUN'T

CONTROLLER CABINET SIZE : MSF65-ATC BASE CABINET: N/A

COMMENTS : Upgraded existing LS 186 controller and STD cabinet with 2070 controller and MSF65-ATC cabinet with adapter plate. Renumbered signal phases per SRC 2022-116. --N.Kobayashi