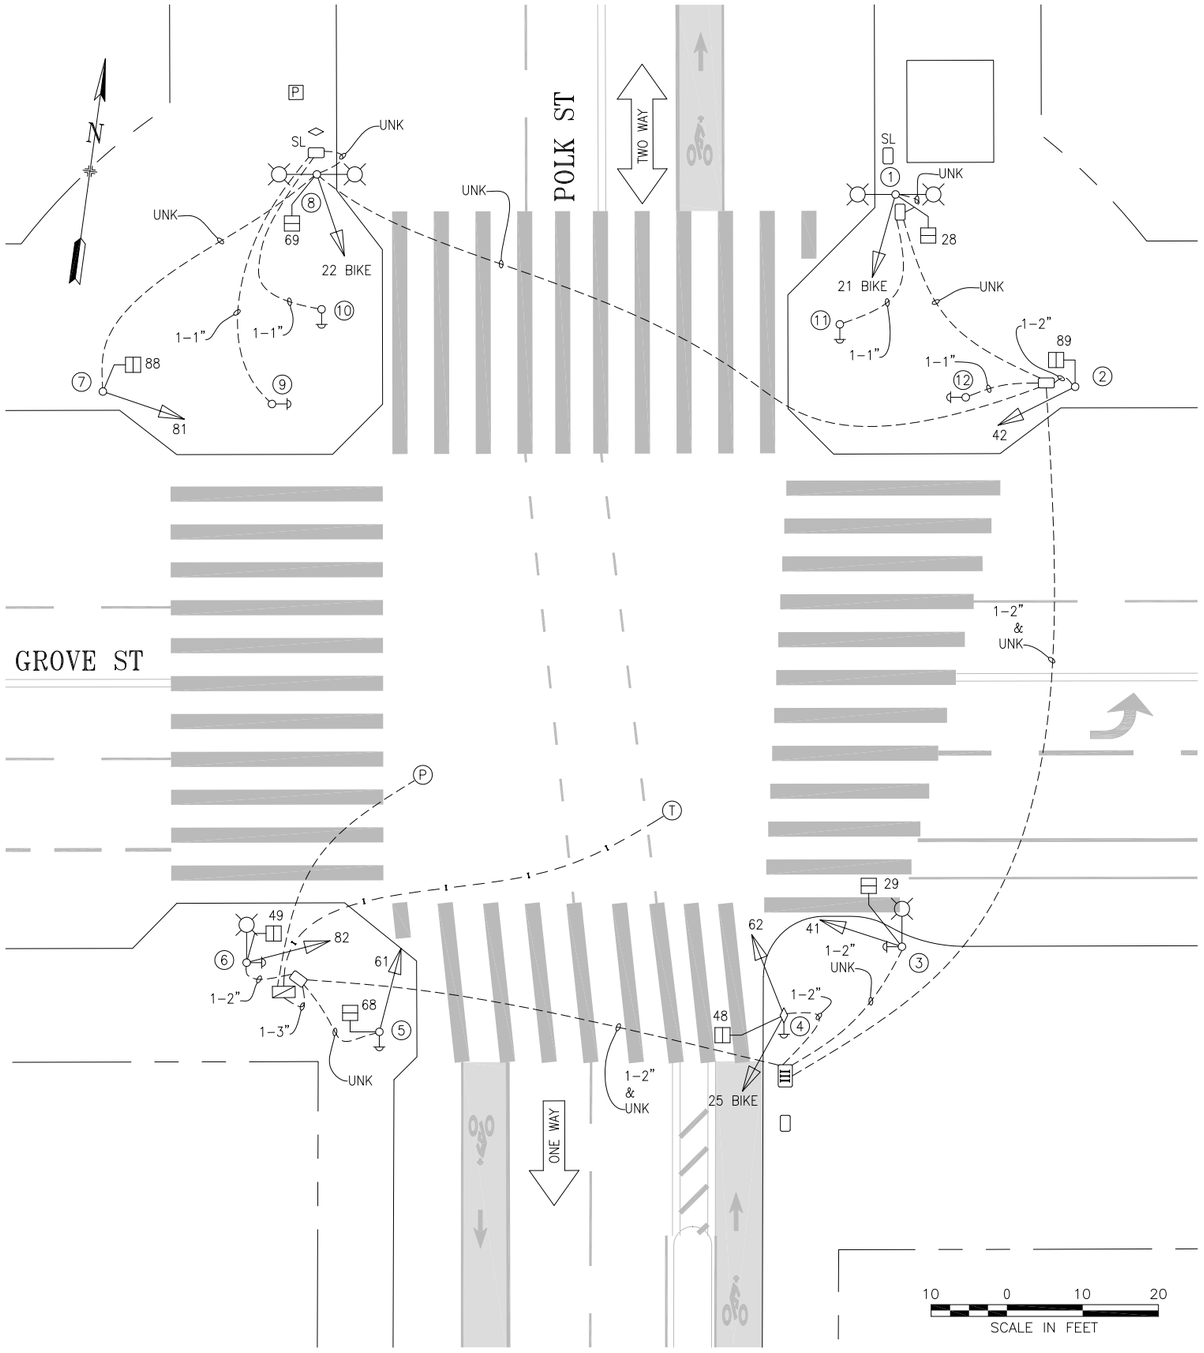

POLE AND EQUIPMENT SCHEDULE

POLE No.	TYPE OF POLE	VEHICLE SIGNAL					PEDESTRIAN SIGNAL			REMARKS
		No.	TYPE	MOUNTING	VISORS	LOUVERS	No.	TYPE	MOUNTING	
1	ORNAMENTAL SL	21	3S12" (BIKE)	SV-1-T	T		28	1S-COUNT	SP-1-T	
2	1-A (10')	42	3S12"	TV-1-T	T		89	1S-COUNT	SP-1	
3	MARBLELITE SL	41	3S12"	SV-1-T	T		29	1S-COUNT	SP-1-T	AUDIBLE PPB
4	MUNI	62 25	3S12" 3S12" (BIKE)	SV-2-TA	T T		48	1S-COUNT	SP-1-T	EXTERNAL CONDUIT AUDIBLE PPB
5	MARBLELITE STANDARD	61	3S12"	TV-1-T	T		68	1S-COUNT	SP-1	AUDIBLE PPB
6	MARBLELITE SL	82	3S12"	SV-1-T	T		49	1S-COUNT	SP-1	AUDIBLE PPB
7	MARBLELITE STANDARD	81	3S12"	TV-1-T	T		8	1S-COUNT	SP-1	
8	ORNAMENTAL SL	22	3S12" (BIKE)	SV-1-T	T		69	1S-COUNT	SP-1	
9	PPB POLE									AUDIBLE PPB
10	PPB POLE									AUDIBLE PPB
11	PPB POLE									AUDIBLE PPB
12	PPB POLE									AUDIBLE PPB

NO.	DATE	DESCRIPTION	BY	APP.
1	05/01/14	ADDED BIKE SIGNALS 21, 22 & 25 PER SRC 2014-033	DRC	DVS
0	09/15/04	SIGNAL UPGRADE ACTIVATED BY 04805. CONVERTED FROM AS BUILTS	GD	BBD

TABLE OF REVISIONS
CHECK WITH TRACING TO SEE IF YOU HAVE LATEST REVISION

REFERENCE INFORMATION & FILE NO. OF SURVEYS

SAN FRANCISCO MUNICIPAL TRANSPORTATION AGENCY
CITY AND COUNTY OF SAN FRANCISCO

DRAWN: AH DATE: 10/23/17
CHECKED: WT DATE: 10/23/17

SCALE: AS SHOWN
SHEET OF SHEETS: 1 OF 1

TRAFFIC SIGNAL INVENTORY DIAGRAM
GROVE STREET AND POLK STREET

CNN NO. 24437000
REV NO. 1