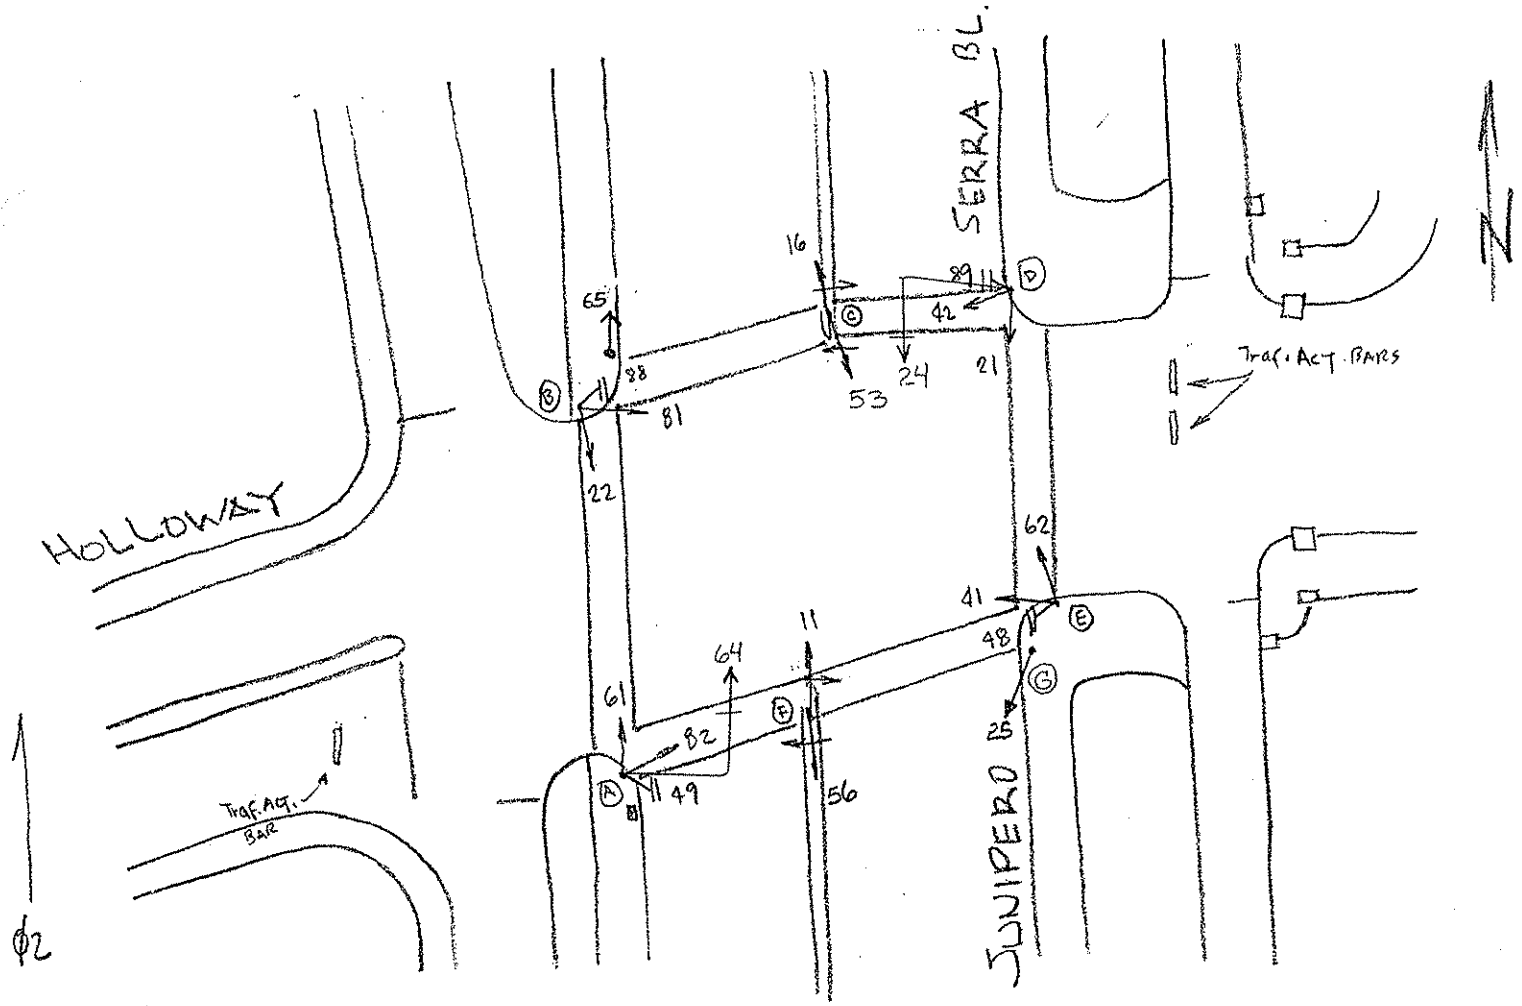

9-17-92

POLE	FUNC.	MAT'L
A	S	S
B	S	C
C	L	C
D	S	S
E	S	C
F	L	C
G	S	S

SIGNAL NO.	MAKE	NO. OF SECT.	SIZE	VISOR	B.P. OR LOUVERS	MOUN'T
82	TCT	3	12"	FC 12"	No	S
61	EC	3	12"	FC 12"	No	S
22	GA	3	8"	FC 8"	No	T
81	TCT	3	12"	FC 12"	No	T
65	TCT	3	12"	FC 12"	No	T
23	PV	3	12"	FC 12"	No	S
16	EC	3	12"	FC 12"	No	S
42	TCT	3	12"	FC 12"	No	S
21	TCT	3	12"	FC 12"	No	S
62	EA	3	8"	FC 8"	No	T
41	TCT	3	12"	FC 12"	No	T
25	TCT	3	12"	FC 12"	No	T
11	TCT	3	12"	FC 12"	No	S
24 64	TCT	3	12"	FC 12"	BP	MAS
56	TCT	3	12"	FC 12" CAP	No	S

PED SIGNAL NO.	LEGEND	MESSAGE ELEMENT	MESSAGE COLOR	MAKE	MOUN'T
49	INT	GRD	W/OR	ICC	S
88	INT	GRD	W/OR	ICC	S
89	INT	GRD	W/OR	ICC	S
48	INT	GRD	W/OR	ICC	S

CONTROLLER CABINET SIZE : ORDINARY BASE CABINET: YES

COMMENTS :