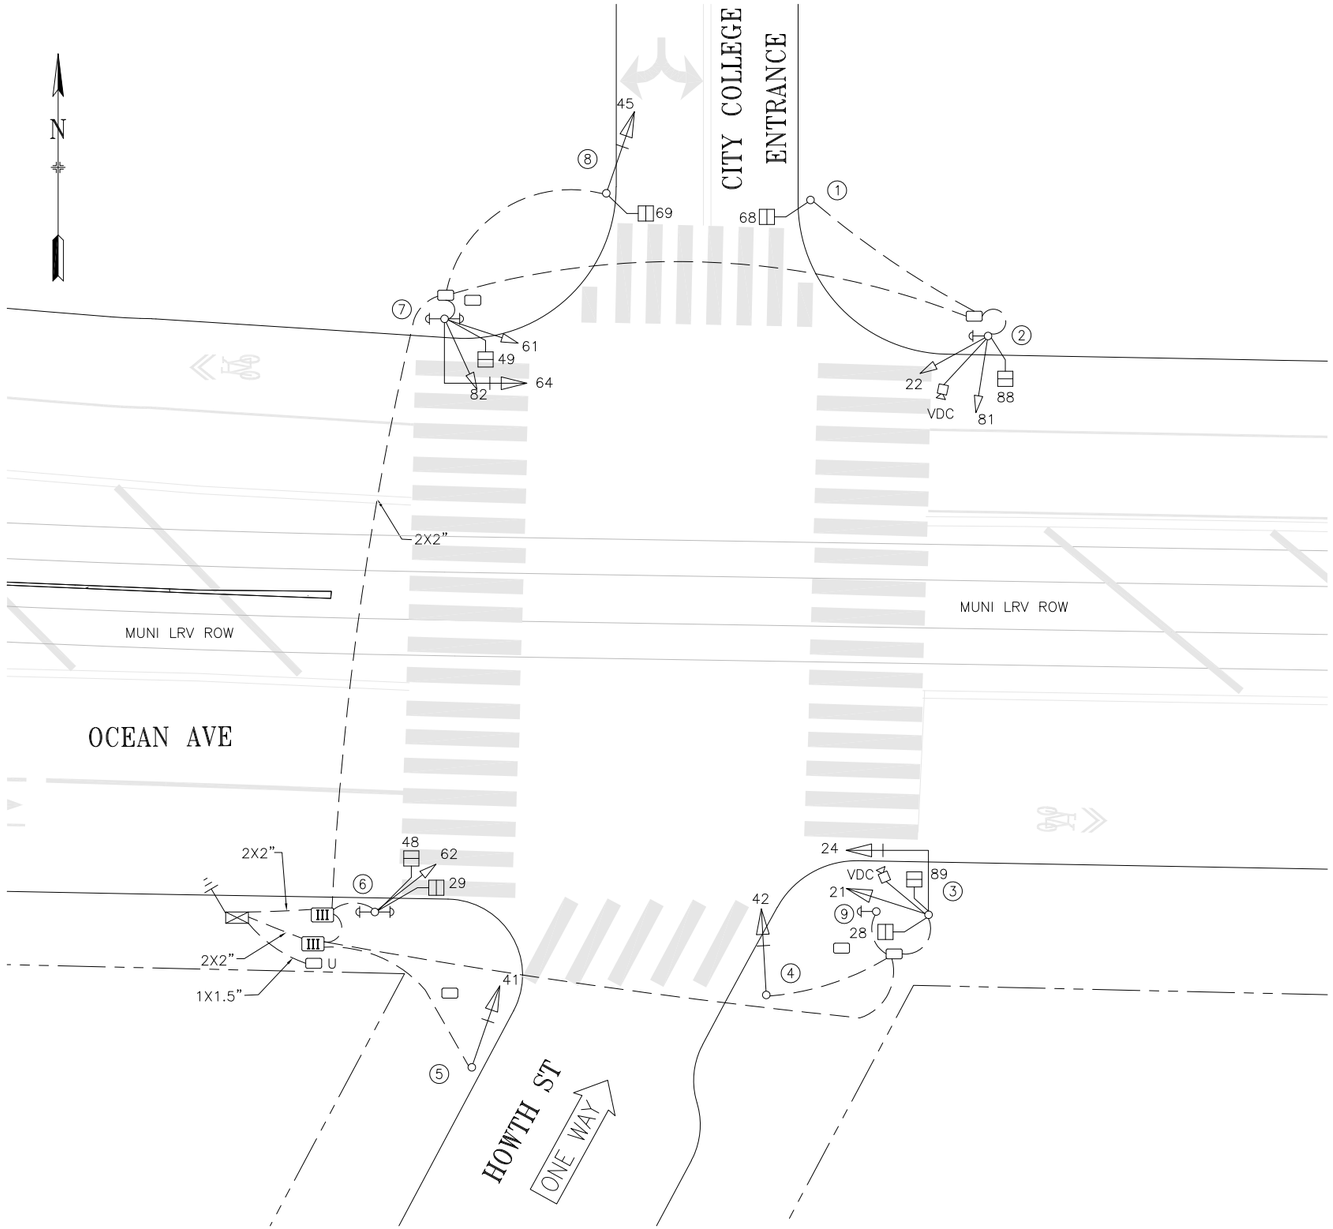

POLE AND EQUIPMENT SCHEDULE

POLE NO.	TYPE OF POLE	VEHICLE SIGNAL			PEDESTRIAN SIGNAL			REMARKS
		NO.	TYPE	MOUNTING	NO.	TYPE	MOUNTING	
1	1-A (7')				68	1S-COUNT	TP-1	
2	MUNI COMBO POLE #800: 0-23	22 81	3S8" 3S8"	SV-2-TA	88	1S-COUNT	SP-1	PPB (1) VIDEO DET. FOR ø8 - HOWTH
3	16-1-70 W/ 8' MA	21 24	3S12" 3S12"	SV-1-T MAS	28 89	1S-COUNT 1S-COUNT	SP-1 SP-1	BACKPLATE VIDEO DET. FOR ø4-DWY
4	1-A (10')	42	3S12"FY	TV-1-T				BACKPLATE
5	1-A (10')	41	3S12"FY	TV-1-T				BACKPLATE
6	1-A (10')	62	3S8"	TV-1	29 48	1S-COUNT 1S-COUNT	SP-1 SP-1	PPB (2)
7	16-1-70 W/ 8' MAST ARM	61 82 64	3S8" 3S8" 3S12"	SV-2-TA MAS	49	1S-COUNT	SP-1	PPB (2) BACKPLATE
8	1-A (10')	45	3S12"FY	TV-1-T	69	1S-COUNT	SP-1	BACKPLATE
9	PPB POLE							PPB (1)

NO.	DATE	DESCRIPTION	BY	APP.
3	2/20/19	SRC 2018-452. REMOVE PPB FOR NORTH/SOUTH XWALKS. CHANGE 41,42,45 TO FY. ADD BP FOR SIGNAL 45 PER FIELD	DYeung	GDeLeon
2	09/11/18	CHANGED 21 TO 12" HEADS, MOVED PPB FOR BBP FROM POLE 3 TO POLE 9, UPDATED 41..42	STL	NW
1	08/07/08	UPDATED PED SIGNALS TO COUNTDOWN PER FIELD CHECK	DY	AH
0	10/11/07	OCEAN AVE AND HOWTH STREET TRAFFIC SIGNAL IMPROVEMENT	DY	AH

TABLE OF REVISIONS
CHECK WITH TRACING TO SEE IF YOU HAVE LATEST REVISION

REFERENCE INFORMATION & FILE NO. OF SURVEYS

SAN FRANCISCO MUNICIPAL TRANSPORTATION AGENCY
CITY AND COUNTY OF SAN FRANCISCO

DRAWN: DY DATE: 9/14/07
CHECKED: AH DATE: 9/14/07

SCALE: 1" = 10'
SHEET OF SHEETS 1 OF 1

TRAFFIC SIGNAL INVENTORY DIAGRAM
HOWTH STREET AND OCEAN AVENUE

CNN NO. 22193000
REV NO. 3