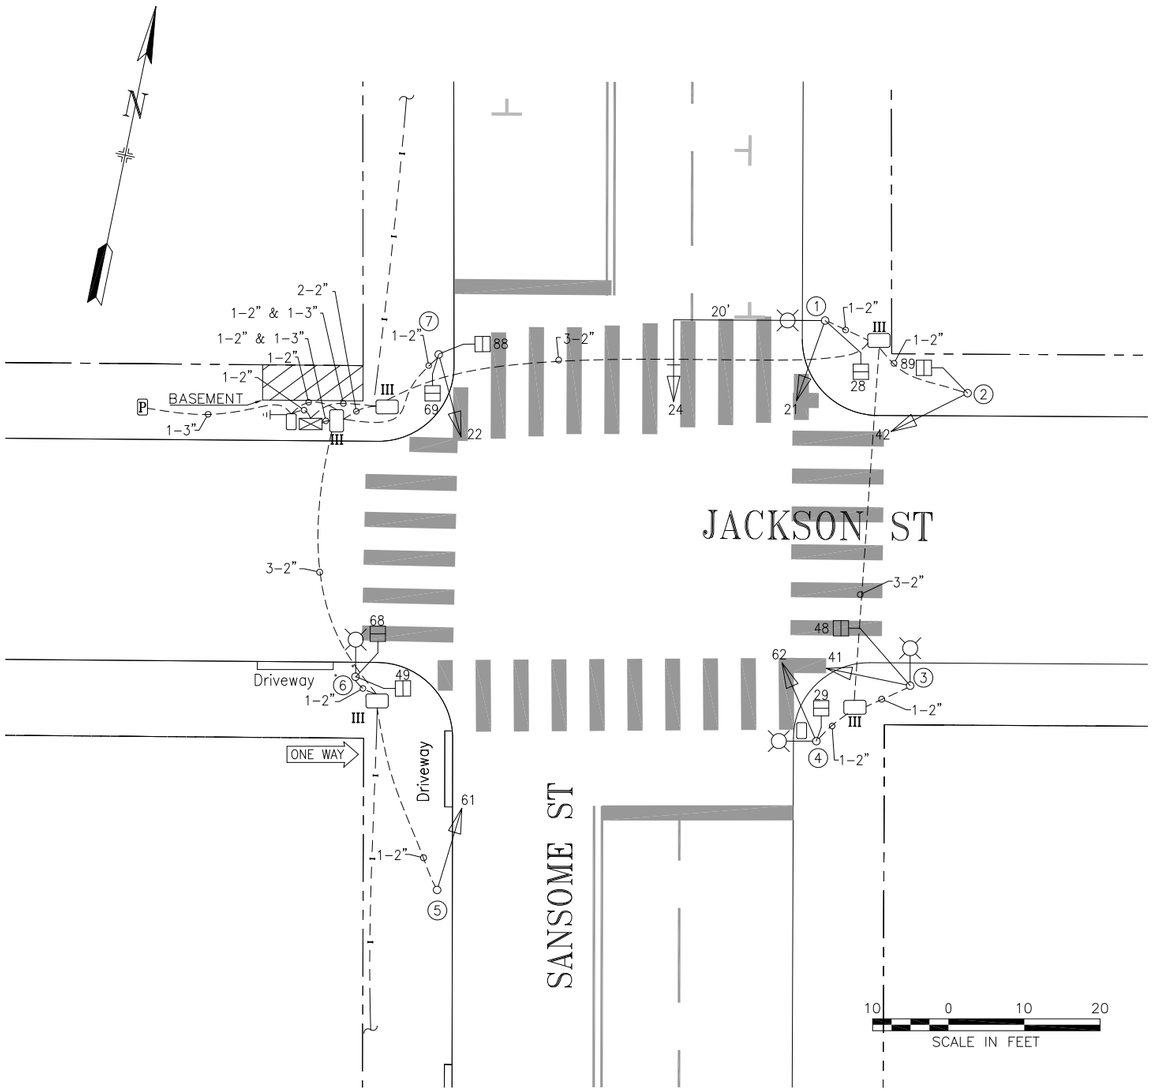

POLE AND EQUIPMENT SCHEDULE

POLE No.	TYPE OF POLE	LUMINAIRE VOLTAGE/ WATTAGE	VEHICLE SIGNAL					PEDESTRIAN SIGNAL			REMARKS
			No.	TYPE	MOUNTING	VISORS	LOUVERS	No.	TYPE	MOUNTING	
1	17-2-100 W/ 20' MAST ARM AND 6' LA	150W	21 24	3S12" 3S12"	SV-1-T MAS	T T		28	1S-COUNT	SP-1	BACKPLATE
2	1-A (10')		42	3S12"	TV-1-T	T		89	1S-COUNT	SP-1	
3	CITY STANDARD STREET LIGHT	150W	41	3S12"	SV-1-T	T		48	1S-COUNT	SP-1	
4	CITY STANDARD STREET LIGHT	150W	62	3S12"	SV-1-T	T		29	1S-COUNT	SP-1	
5	1-A (10')		61	3S12"	TV-1-T	T					
6	CITY STANDARD STREET LIGHT	150W						68 49	1S-COUNT 1S-COUNT	SP-2-T	
7	1-A (10')		22	3S12"	TV-1-T	T		69 88	1S-COUNT 1S-COUNT	SP-1(22") SF-1-SF(12")	

NO.	DATE	DESCRIPTION	BY	APP.
0	5/26/16	ACTIVATED BY CONTRACT 2567J;CONVERTED BY AS-BUILTS	IRT	MV

TABLE OF REVISIONS
CHECK WITH TRACING TO SEE IF YOU HAVE LATEST REVISION

REFERENCE INFORMATION & FILE NO. OF SURVEYS

SAN FRANCISCO MUNICIPAL TRANSPORTATION AGENCY
CITY AND COUNTY OF SAN FRANCISCO

DRAWN: IRT DATE: 11/15/17
CHECKED: MV DATE: 11/15/17

SCALE: AS SHOWN
SHEET OF SHEETS

TRAFFIC SIGNAL INVENTORY DIAGRAM
SANSOME STREET AND JACKSON STREET

CNN NO. 24712000
REV NO. 0