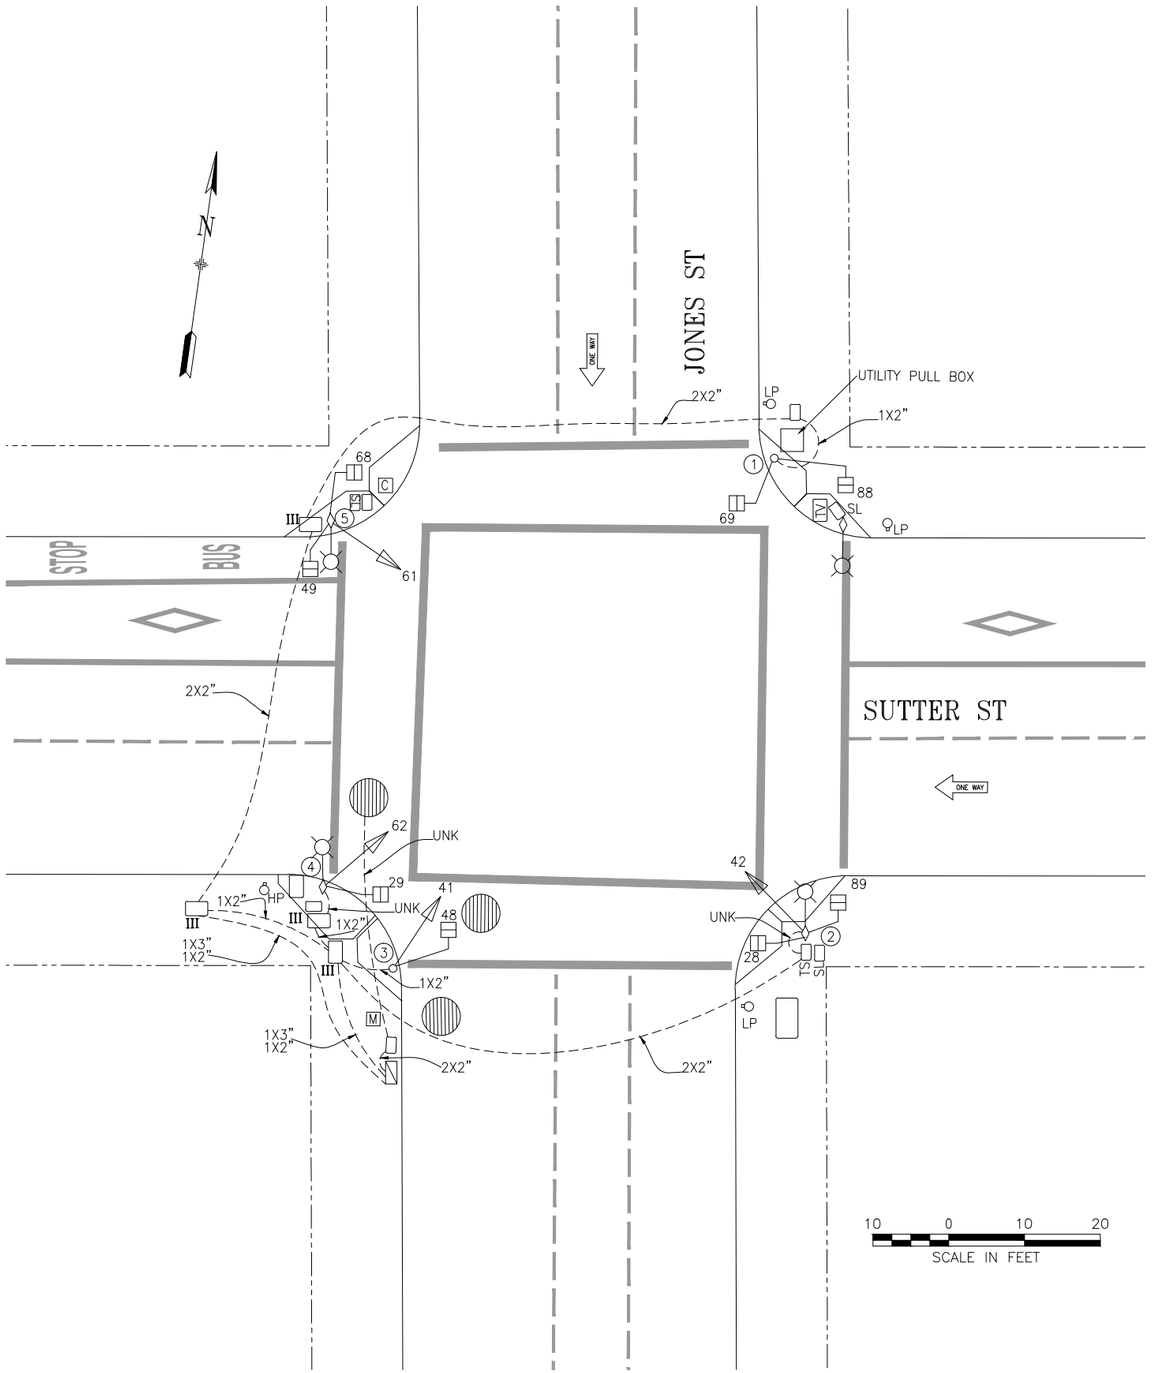

POLE AND EQUIPMENT SCHEDULE

POLE No.	TYPE OF POLE	VEHICLE SIGNAL					PEDESTRIAN SIGNAL			REMARKS
		No.	TYPE	MOUNTING	VISORS	LOUVERS	No.	TYPE	MOUNTING	
1	1-A (7')						69 88	1S-COUNT 1S-COUNT	TP-2-T	
2	MUNI POLE W/ORNAMENTAL SL	42	3S12"	SV-1-T (18")	T		28 89	1S-COUNT 1S-COUNT	SP-1 SP-1	MOUNT 42 AT 11'
3	1-A (10')	41	3S12"	TV-1-T	T		48	1S-COUNT	SP-1	
4	MUNI POLE W/ORNAMENTAL SL	62	3S12"	SV-1 (16")	T		29	1S-COUNT	SP-1	MOUNT 62 AT 11'
5	MUNI POLE W/ORNAMENTAL SL	61	3S12"	SV-1-T	T		49 68	1S-COUNT 1S-COUNT	SP-1-SF (12") SP-1 (22")	MOUNT 61 AT 11'

NO.	DATE	DESCRIPTION	BY	APP.
0	05/07/14	SIGNAL UPGRADE ACTIVATED THRU 1901J AND CONVERTED FROM AS-BUILTS	GD	MVelasco

TABLE OF REVISIONS
CHECK WITH TRACING TO SEE IF YOU HAVE LATEST REVISION

COMPLETION DATE / ELECTRICIAN INITIAL

SAN FRANCISCO MUNICIPAL TRANSPORTATION AGENCY
TRANSPORTATION ENGINEERING
CITY AND COUNTY OF SAN FRANCISCO

DRAWN: AScales DATE: 0/06/2015
CHECKED: MVelasco DATE: 07/2015
SCALE: AS SHOWN
SHEET OF SHEETS: 1 OF 1

TRAFFIC SIGNAL INVENTORY DIAGRAM
JONES STREET AND SUTTER STREET

CNN NO. 24959000
REV. NO. 0