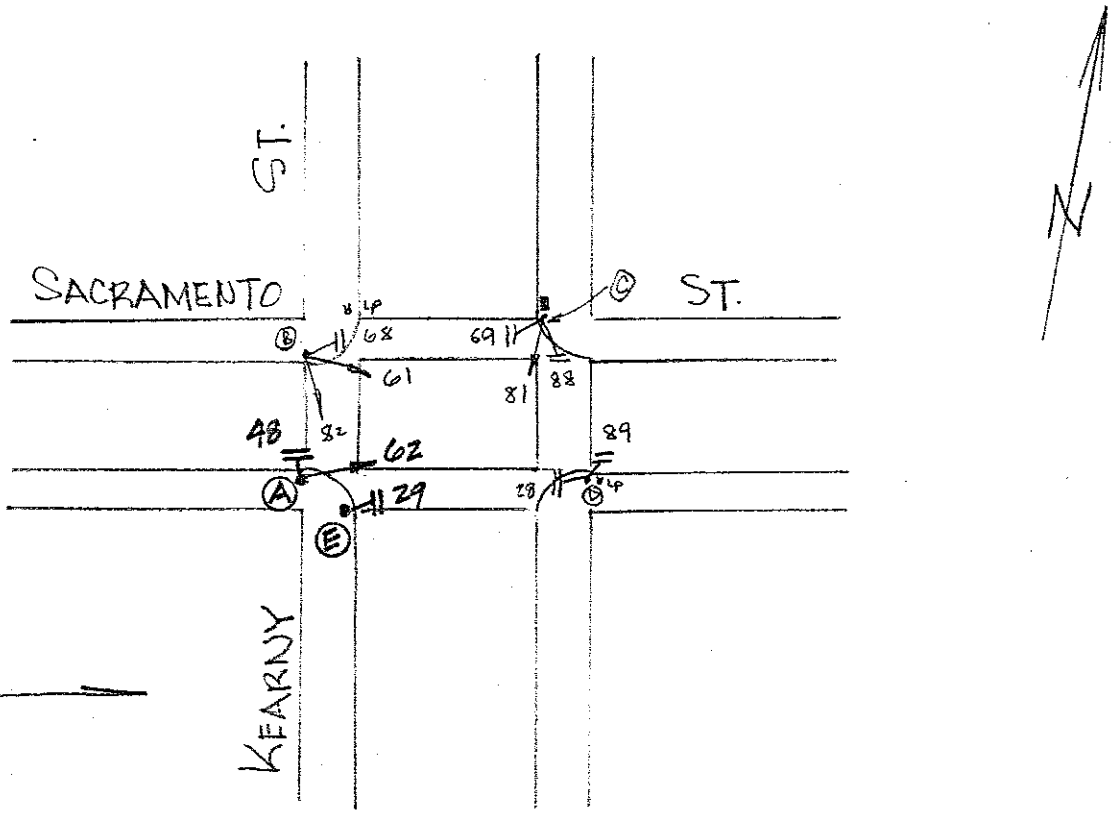

≈ 4/90

POLE	FUNC.	MAT'L
A	L	S
B	L	S
C	L	S
D	L	S
E	L	S

SIGNAL NO.	MAKE	NO. OF SECT.	SIZE	VISOR	B.P. OR LOUVERS	MOUN'T
62	EC	3	8"	FC 8"	NO	S
82	EC	3	8"	FC 8"	NO	S
61	EC	3	8"	FC 8"	NO	S
81	EC	3	8"	FC 8"	NO	S

PED SIGNAL NO.	LEGEND	MESSAGE ELEMENT	MESSAGE COLOR	MAKE	MOUN'T
29	I	19-1	W/OR	166	S
48	I	19-1	W/OR	166	S
68	W/DW	GRD	W/OR	ED	S
69	W/DW	GRD	W/OR	ED	S
88	W/DW	GRD	W/OR	ED	S
89	W/DW	GRD	W/OR	ED	S
28	W/DW	GRD	W/OR	ED	S

CONTROLLER CABINET SIZE : ORDINARY BASE CABINET: YES

COMMENTS :