SUTTER & KEARNY

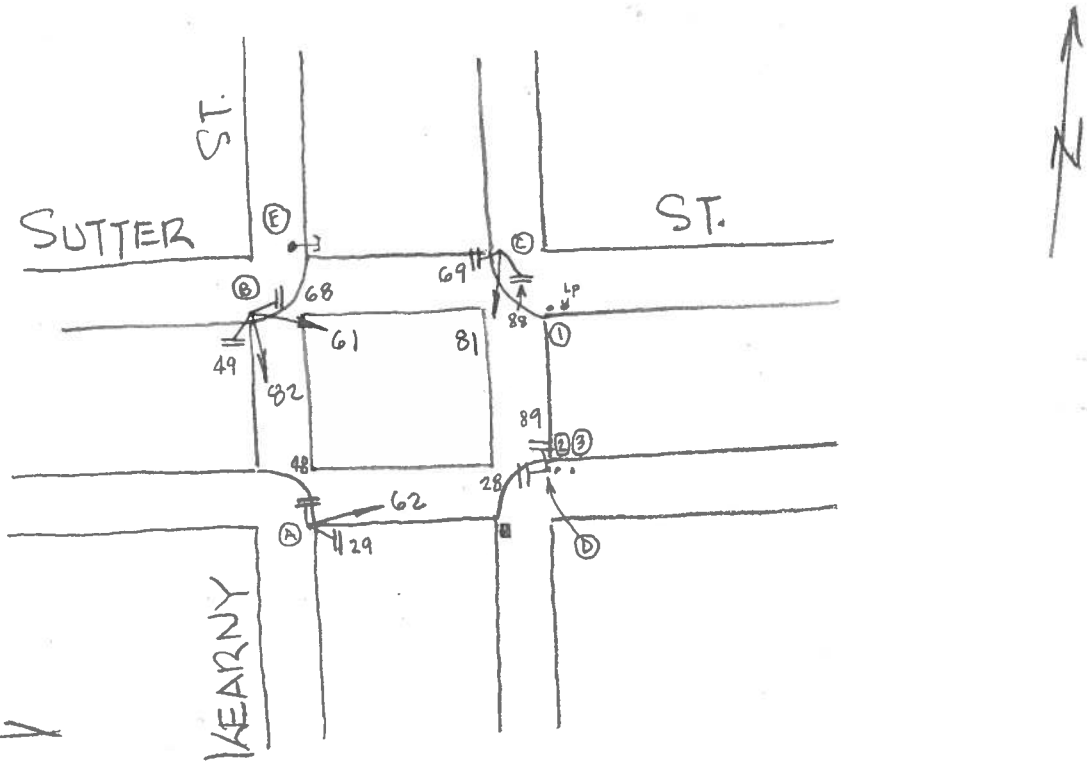


10-26-17

| POLE | FUNC. | MAT'L |
|---|---|---|
| A | S | S |
| B | L | O |
| C | S | S |
| D | S | S |
| E | I-A | (10') |
| 1 | M | S |
| 2 | M | S |
| 3 | L | O |

| SIGNAL NO. | MAKE | NO. OF SECT. | SIZE | VISOR | B.P. OR LOUVERS | MOUN'T |
|---|---|---|---|---|---|---|
| 62 | TCT | 3 | 8" | FC 8" | NO | T |
| 82 | EA | 3 | 8" | FC 8" | NO | S |
| 61 | EA | 3 | 8" | FC 8" | NO | S |
| 81 | GA | 3 | 12" | FC 12" | NO | T |

| PED SIGNAL NO. | LEGEND | MESSAGE ELEMENT | MESSAGE COLOR | MAKE | MOUN'T |
|---|---|---|---|---|---|
| 29 | I | IS-I | W/OR | ICC | S |
| 48 | I | IS-I | W/OR | ICC | S |
| 49 | W/DW | GRD | W/OR | ED | S |
| 68 | W/DW | GRD | W/OR | ES | S |
| 69 | I | IS-I | W/OR | ICC | S |
| 88 | I | IS-I | W/OR | ICC | S |
| 89 | I | IS-I | W/OR | ICC | S |
| 28 | I | IS-I | W/OR | ICC | S |

CONTROLLER CABINET SIZE : ORDINARY BASE CABINET: NO

COMMENTS: PER FIELD - ADD POLE E WITH CONDUIT STUB.
UPGRADE 81 TO 12-INCH

- DYEUNG