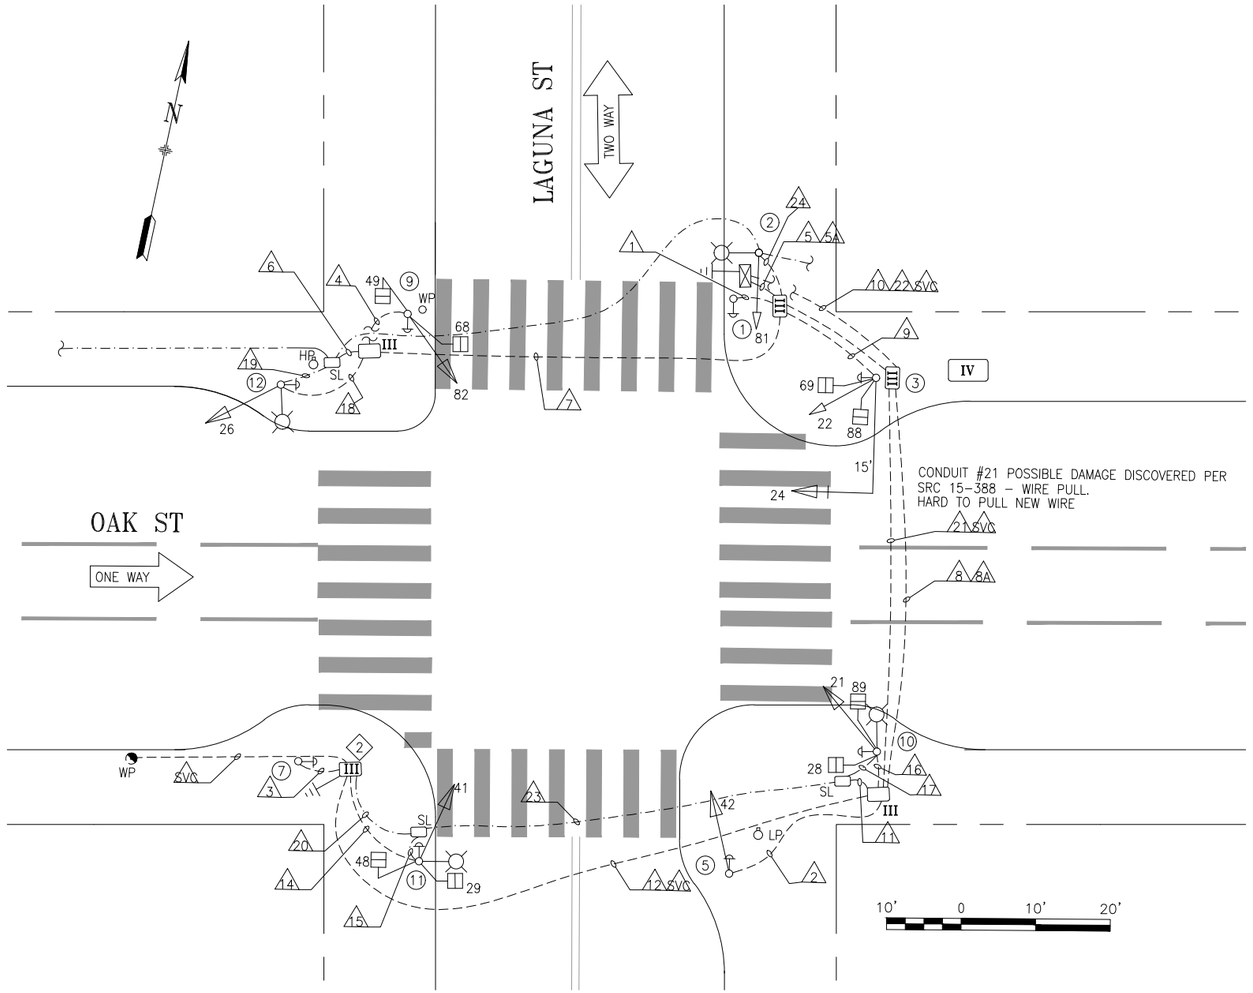

POLE AND EQUIPMENT SCHEDULE

POLE No.	TYPE OF POLE	LUMINAIRE VOLTAGE/ WATTAGE	VEHICLE SIGNAL No.	VEHICLE SIGNAL TYPE	VEHICLE SIGNAL MOUNTING	VEHICLE SIGNAL VISORS	VEHICLE SIGNAL LOUVERS	PEDESTRIAN SIGNAL No.	PEDESTRIAN SIGNAL TYPE	PEDESTRIAN SIGNAL MOUNTING	REMARKS
1	PPBP										APS 2-W
2	EX SL	250W 240V HPS	81	3S8"	SV-1-T	T					
3	16-1-70 W/ 15' MAST ARM		22 24	3S8" 3S12"	SV-1-T MAS	T T		88 69	1S-COUNT 1S-COUNT	SP-1 SP-1	APS 2-W
4											
5	1-A (10')		42	3S12"	TV-1-T	T					APS 2-W
6											
7	PPBP										APS 2-W
8											
9	1-A (10')		82	3S12"	TV-1-T	T		49 68	1S-COUNT 1S-COUNT	SP-1 SP-1	APS 2-W
10	CITY STANDARD STEEL STREET LIGHT POLE (25')	108 LED	21	3S12"	SV-1-T	T		28 89	1S-COUNT 1S-COUNT	SP-1 SP-1	APS 2-W
11	CITY STANDARD STEEL STREET LIGHT POLE (25')	108 LED	41	3S12"	SV-1-T	T		29 48	1S-COUNT 1S-COUNT	SP-1 SP-1	APS 2-W
12	CITY STANDARD STEEL STREET LIGHT POLE (28')	108 LED	26	3S12"	SV-1-T	T					APS 2-W 1

SHEET NOTES

1. STREET LIGHT WIRE INSIDE POLE SEPARATED VIA FLEXIBLE PIPE THROUGHOUT LENGTH OF POLE AND SECURED USING KELLEM GRIP.
2. SOUTH SIDE STREET LIGHT SERVICE IS SPLICED INTO SAME PHASE AS EXISTING TRAFFIC SIGNAL SERVICE AT THIS PULLBOX

NO.	DATE	DESCRIPTION	BY	APP.
0	1/31/19	CONVERT 2657J/1660N AS-BUILTS. ADD APS VIA SRC 2019-020	DYeung	GDeLeon

TABLE OF REVISIONS
CHECK WITH TRACING TO SEE IF YOU HAVE LATEST REVISION

REFERENCE INFORMATION & FILE NO. OF SURVEYS

SAN FRANCISCO MUNICIPAL TRANSPORTATION AGENCY
CITY AND COUNTY OF SAN FRANCISCO

DRAWN: D.Yeung DATE: 2/25/20
CHECKED: G.DeLeon DATE: 2/25/20

SCALE: AS SHOWN
SHEET OF SHEETS: 1 OF 2

TRAFFIC SIGNAL INVENTORY DIAGRAM
LAGUNA STREET AND OAK STREET

CNN NO. 30069000
REV NO. 0