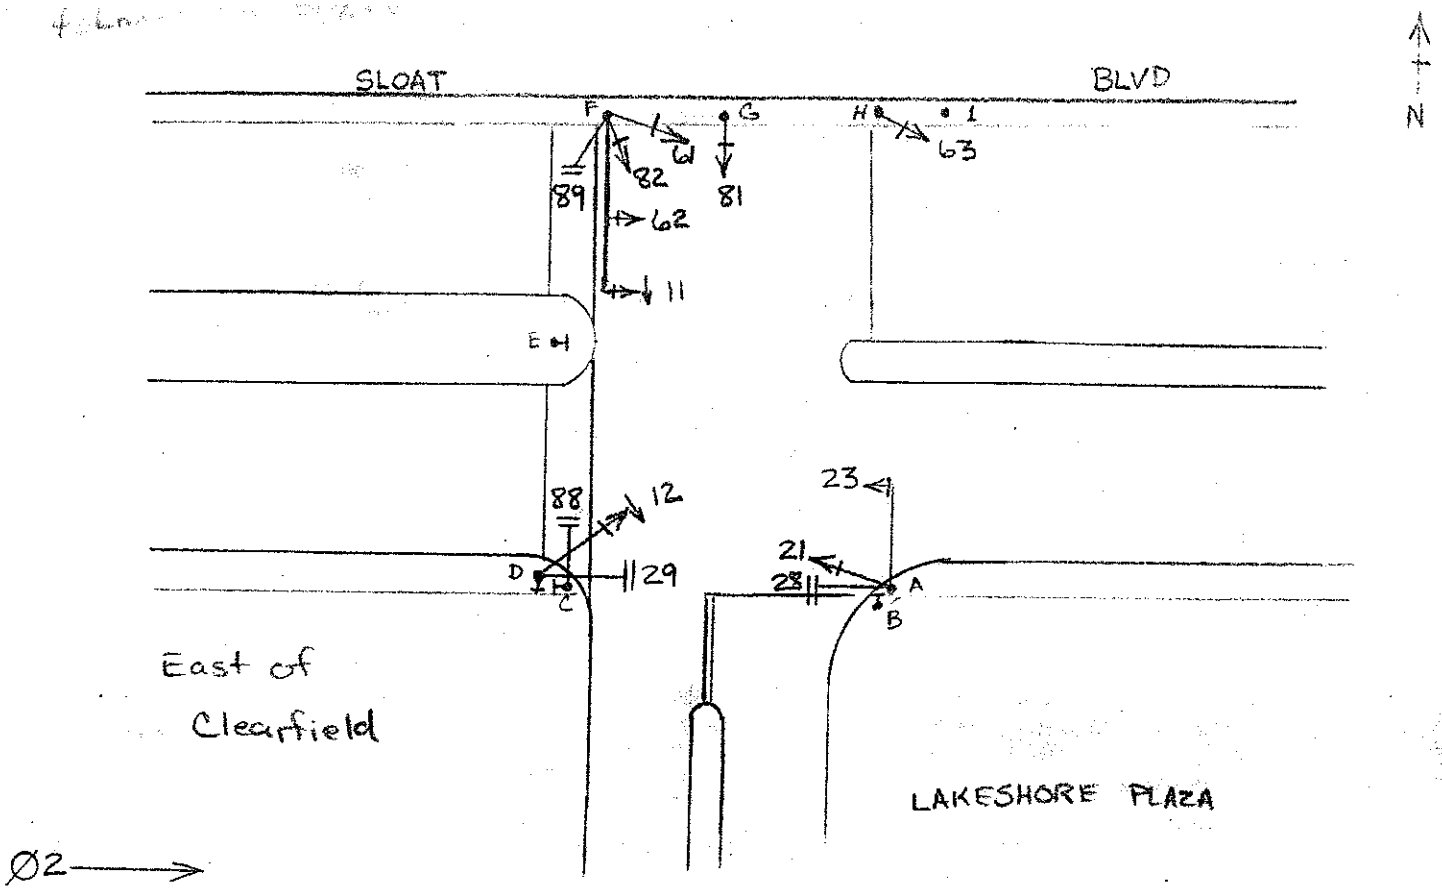

6-29-95

POLE	FUNC.	MAT'L
A	L	S
B	S	S
C	L	S
D	S	S
E	S	S
F	L	S
G	S	S
H	S	S
I	L	C

SIGNAL NO.	MAKE	NO. OF SECT.	SIZE	VISOR	B.P. OR LOUVERS	MOUN'T
11.	State	3	12" ←	FC	BP	A
12	State	3	12" ←	FC	BP	T
21	PV	3	12"	CAP	BP	S
23	PV	3	12"	CAP	BP	A
61	State	3	12"	FC	BP	S
62	State	3	12"	FC	BP	A
63	State	3	12"	FC	BP	T
81	State	3	12"	FC	BP	T
82	State	3	12"	FC	BP	S

PED SIGNAL NO.	LEGEND	MESSAGE ELEMENT	MESSAGE COLOR	MAKE	MOUN
28	I	15-1	W/OR	ICC	S
29	I	15-1	W/OR	ICC	S

CONTROLLER CABINET SIZE : _____ BASE CABINET: _____

COMMENTS: Couldnot identify make of signals