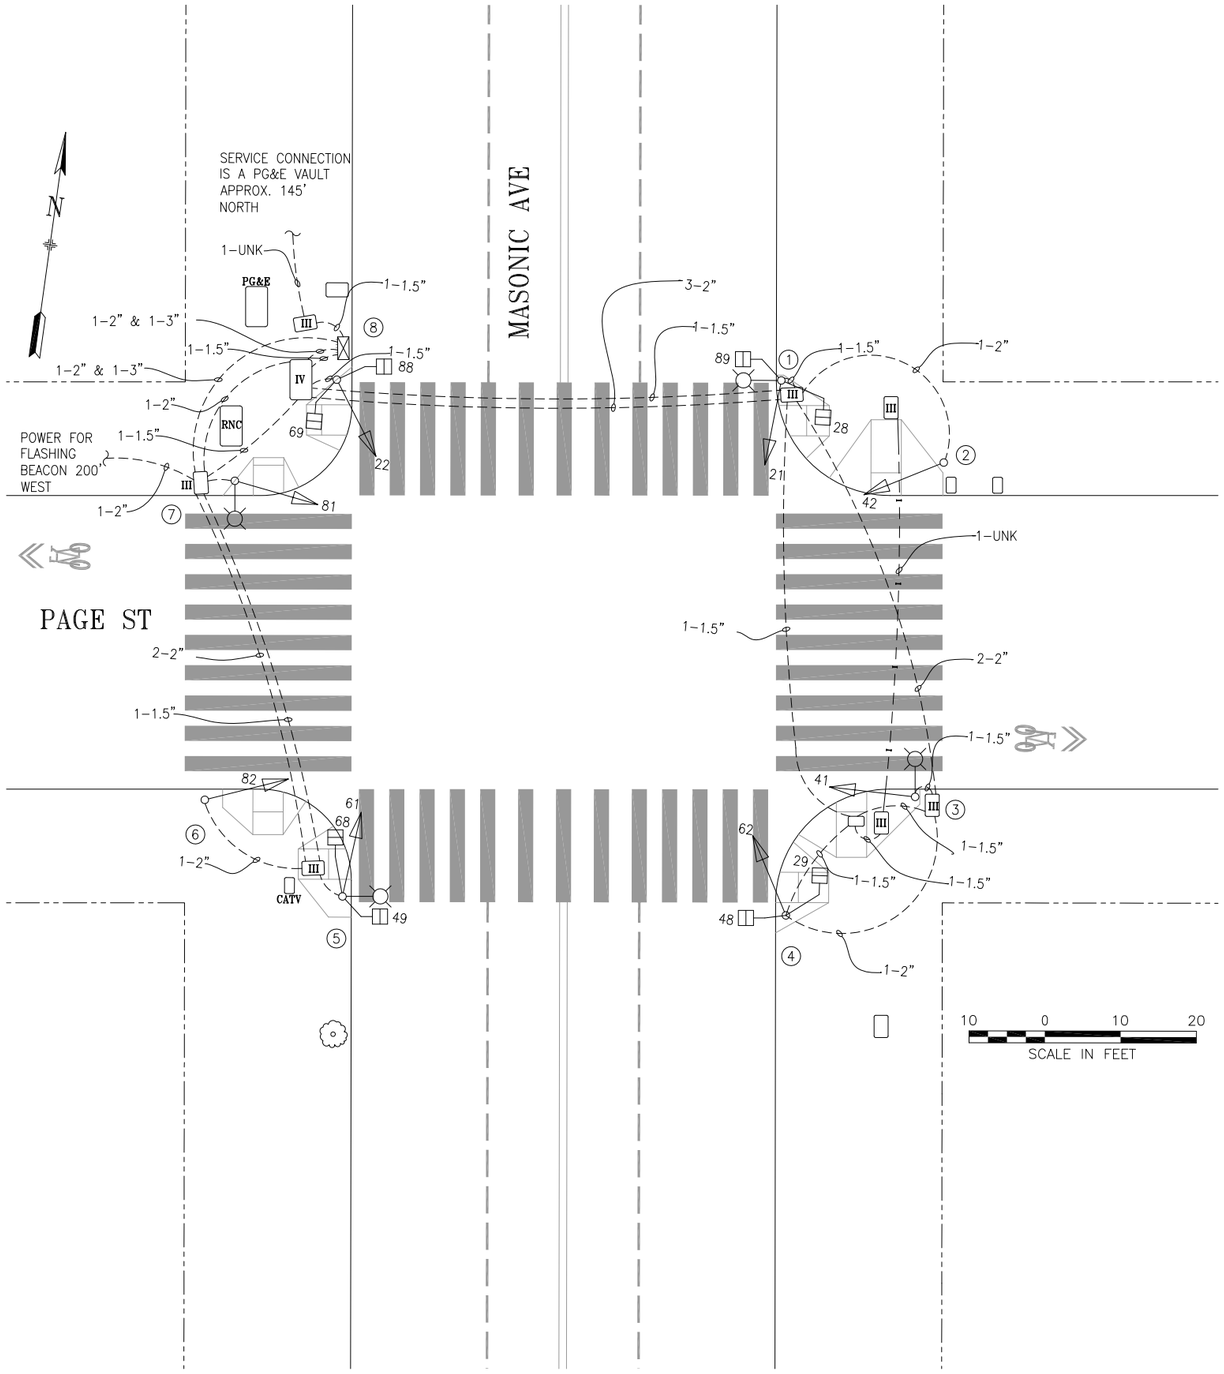

POLE AND EQUIPMENT SCHEDULE

POLE No.	TYPE OF POLE	LUMINAIRE VOLTAGE/ WATTAGE	VEHICLE SIGNAL					PEDESTRIAN SIGNAL			REMARKS
			No.	TYPE	MOUNTING	VISORS	LOUVERS	No.	TYPE	MOUNTING	
1	EX. CITY STANDARD STREET LIGHT		21	3S12"	SV-1-T	T		89 28	1S-COUNT 1S-COUNT	SP-1 SP-1	
2	1-A(10')		42	3S12"	TV-1-T	T					
3	EX. CITY STANDARD STREET LIGHT		41	3S12"	SV-1-T	T					
4	EX. MARBELITE POLE (10')		62	3S12"	TV-1-T	T		48 29	1S-COUNT 1S-COUNT	SP-1 SP-1	
5	EX. CITY STANDARD STREET LIGHT		61	3S12"	SV-1-T	T		49 68	1S-COUNT 1S-COUNT	SP-1 SP-1	MOUNT 61 AT 13 FEET HIGH
6	1-A(10')		82	3S12"	TV-1-T	T					
7	EX. CITY STANDARD STREET LIGHT		81	3S12"	SV-1-T	T					
8	EX. MARBELITE POLE (10')		22	3S12"	TV-1-T	T		69 88	1S-COUNT 1S-COUNT	SP-1 SP-1	

NO.	DATE	DESCRIPTION	BY	APP.
1	2/22/18	ADDED 12" VEHICLE HEADS AND PED SIGNALS PER SRC#2017-345 AND ADDED CONDUITS PER 2821J	JT	KK

TABLE OF REVISIONS
CHECK WITH TRACING TO SEE IF YOU HAVE LATEST REVISION

REFERENCE INFORMATION & FILE NO. OF SURVEYS

SAN FRANCISCO MUNICIPAL TRANSPORTATION AGENCY
CITY AND COUNTY OF SAN FRANCISCO

DRAWN: DATE: E.OROZCO 4/2/2018
CHECKED: DATE: K.KWONG 4/2/2018

SCALE: AS SHOWN
SHEET OF SHEETS 1 OF 1

TRAFFIC SIGNAL INVENTORY DIAGRAM
MASONIC AVENUE AND PAGE STREET

CNN NO. 26344000
REV NO. 0