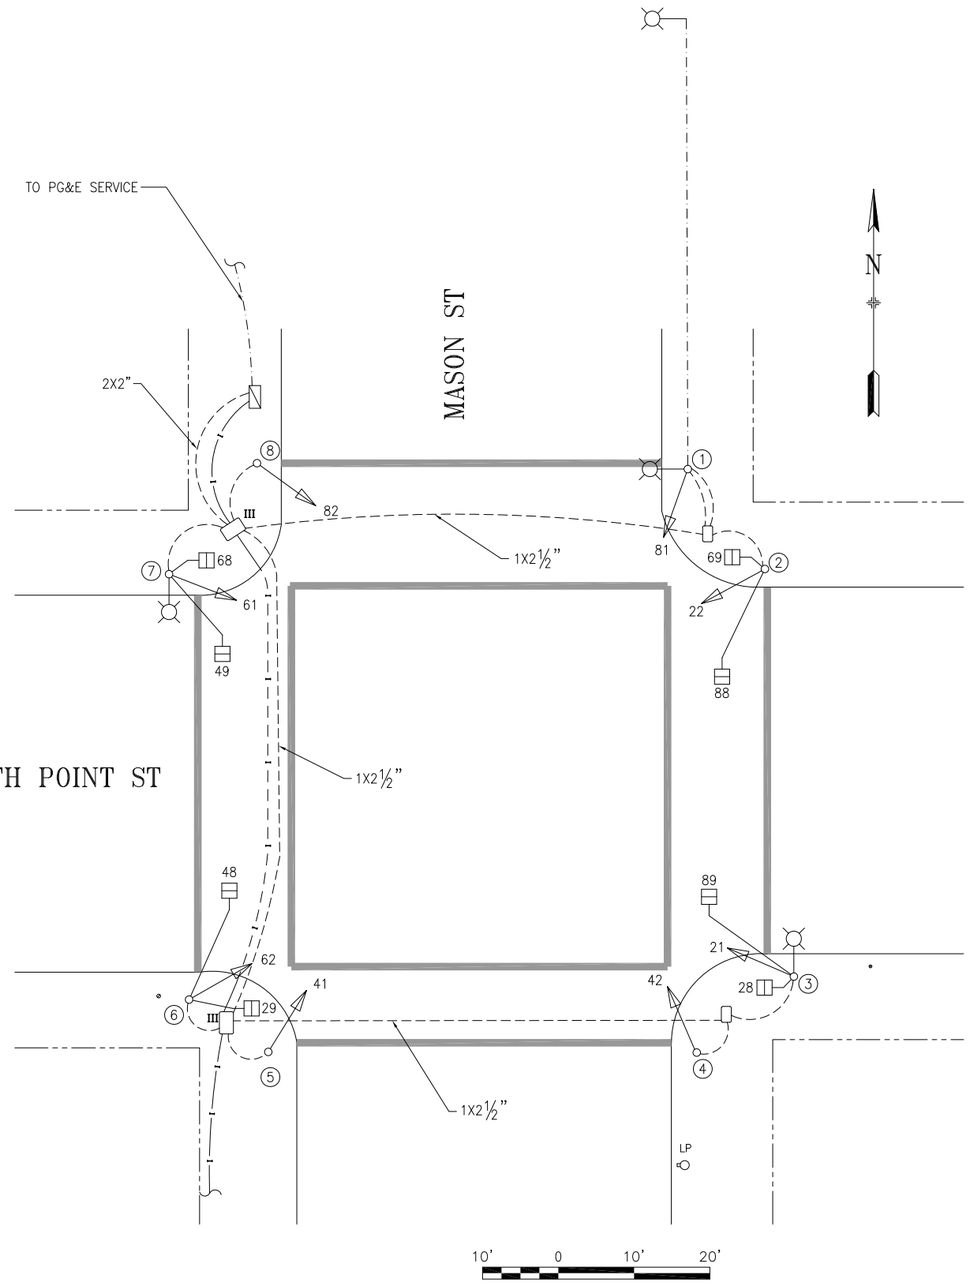

POLE AND EQUIPMENT SCHEDULE

POLE No.	TYPE OF POLE	VEHICLE SIGNAL					PEDESTRIAN SIGNAL			REMARKS
		No.	TYPE	MOUNTING	VISORS	LOUVERS	No.	TYPE	MOUNTING	
1	SL	81	3S12"	SV-1-T	T					
2	1-A (10')	22	3S12"	TV-1-T	T		69 88	1S-COUNT 1S-COUNT	SP-1 SP-1	
3	SL	21	3S12"	SV-1-T	T		28 89	1S-COUNT 1S-COUNT	SP-1 SP-1	
4	1-A (10')	42	3S12"	TV-1-T	T					
5	1- A (10')	41	3S12"	TV-1-T	T					
6	1-A (10')	62	3S12"	TV-1-T	T		29 48	1S-COUNT 1S-COUNT	SP-1 SP-1	
7	SL	61	3S12"	SV-1-T	T		49 68	1S-COUNT 1S-COUNT	SP-1 SP-1	
8	1-A (10')	82	3S12"	TV-1-T	T					

NOTE:

CABINET FOUNDATION TYPE: STD

NO.	DATE	DESCRIPTION	BY	APP.
3	04/25/18	UPGRADE LENSES TO 12" PER SRC 18-100	GW	BW
2	08/01/11	ADD SIGNALS 28,29,68,69 PER SRC 10-080	ET	HQ
1	07/97	BAY & NORTH PT. PROJECT JOB# 1094 N	DVC	RO

TABLE OF REVISIONS
CHECK WITH TRACING TO SEE IF YOU HAVE LATEST REVISION

REFERENCE INFORMATION & FILE NO. OF SURVEYS

SAN FRANCISCO MUNICIPAL TRANSPORTATION AGENCY

CITY AND COUNTY OF SAN FRANCISCO

DRAWN: DVC DATE: 8/29/01
CHECKED: DATE:

SCALE: AS SHOWN
SHEET OF SHEETS: 1 OF 1

TRAFFIC SIGNAL INVENTORY DIAGRAM

NORTH POINT ST & MASON ST

CNN NO. 25481000
REV NO. 3

EXTERNAL REFERENCES:
FONTS USED: arialn.ttf ARIBLK.TTF ltypeshp.shx ROMAND.shx ROMANS.shx ROMANS.SHX ROMANT.txt

SCALE FACTOR: 120
PLOT SCALE: 1=1

ORIGIN: Sales & Tax

FILE NAME: Mason_North Point.dwg
DATE: Aug 30 2001 12:56