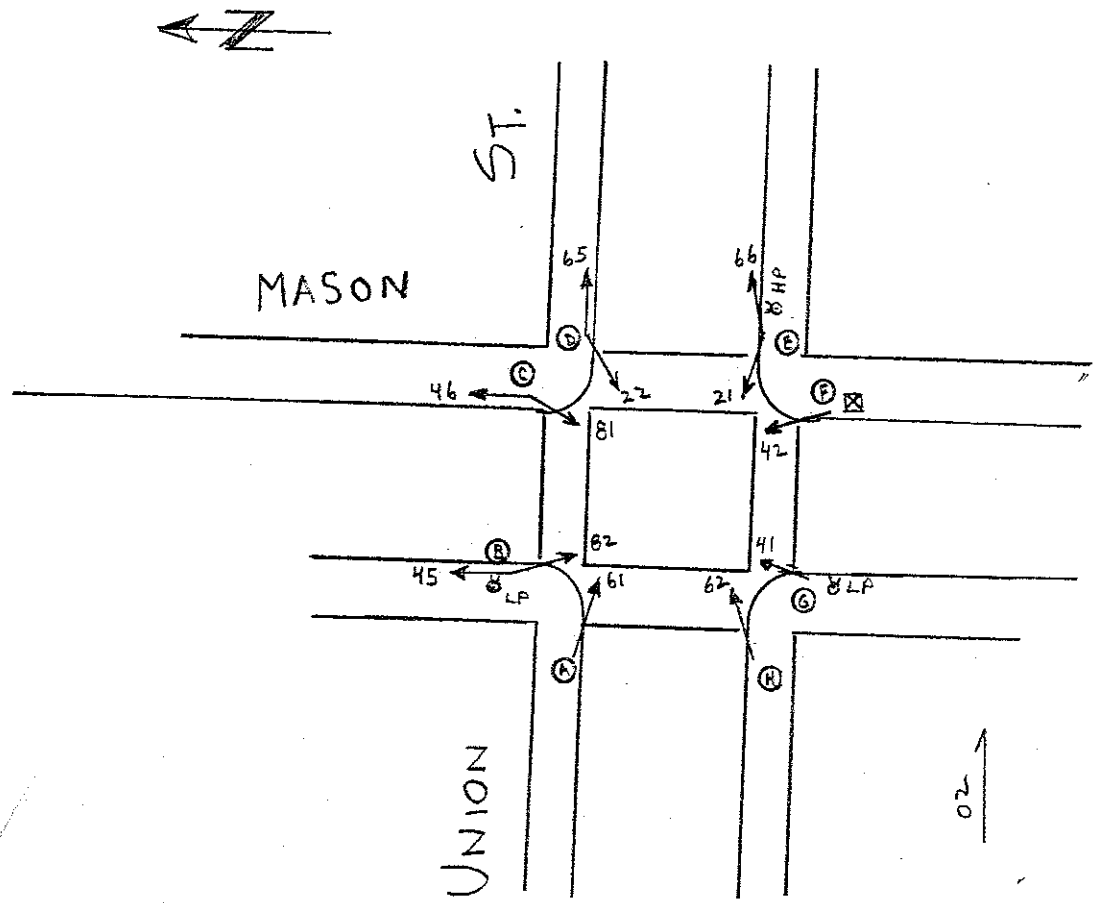

8-2-84

POLE	FUNC.	MAT'L
A	M	S
B	S	S
C	S	S
D	LP	S
E	M	S
F	S	S
G	LP	S
H	LP	S

SIGNAL NO.	MAKE	NO. OF SECT.	SIZE	VISOR	B.P. OR LOUVERS	MOUN'T
61	EC	3	8"	FC 8"	No	S
82	EC	3	8"	FC 8"	No	T
45	EC	3	8"	FC 8"	No	T
46	EC	3	8"	FC 8"	No	T
81	EC	3	8"	FC 8"	No	T
22	EC	3	8"	FC 8"	No	S
65	EC	3	8"	FC 8"	No	S
66	EC	3	8"	FC 8"	No	S
21	EC	3	8"	FC 8"	No	S
42	EC	3	8"	FC 8"	No	T
41	EC	3	8"	FC 8"	No	S
62	EC	3	8"	FC 8"	No	S

PED SIGNAL NO.	LEGEND	MESSAGE ELEMENT	MESSAGE COLOR	MAKE	MOUN'T

CONTROLLER CABINET SIZE : LARGE BASE CABINET: _____

COMMENTS :