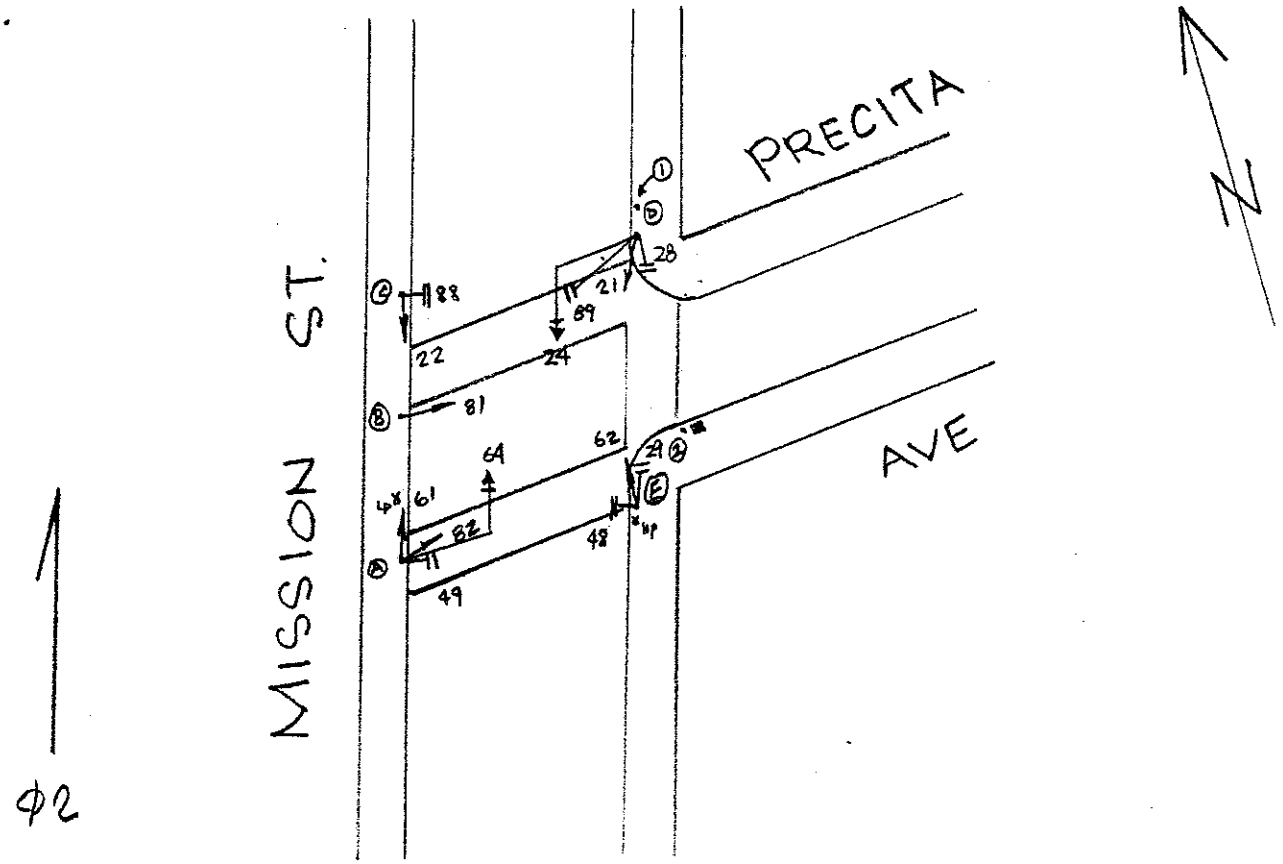

Signal Upgrade switchover 11/9/99

POLE	FUNC.	MAT'L
A	S	S
B	S	S
C	S	S
D	S	S
E	S	S
1	M	S
2	U	W

SIGNAL NO.	MAKE	NO. OF SECT.	SIZE	VISOR	B.P. OR LOUVERS	MOUN'T
82	CH	3	8"	T 8"	NO	S
61	CH	3	8"	T 8"	NO	S
81	CH	3	8"	T 8"	NO	T
22	CH	3	8"	T 8"	NO	T
21	CH	3	8"	T 8"	NO	S
62	CH	3	8"	T 8"	NO	T
64	CH	3	12"	T 12"	BP	A
24	CH	3	12"	T 12"	BP	A

PED SIGNAL NO.	LEGEND	MESSAGE ELEMENT	MESSAGE COLOR	MAKE	MOUN'
49	I	IS-1	W/OR	ICC	S
88	I	IS-1	W/OR	ICC	S
89	I	IS-1	W/OR	ICC	S
48	I	IS-1	W/OR	ICC	S
28	I	IS-1	W/OR	ICC	S
29	I	IS-1	W/OR	ICC	S

CONTROLLER CABINET SIZE : ORDINARY BASE CABINET: YES

COMMENTS: Signal upgrade: added mast arms + ped heads.