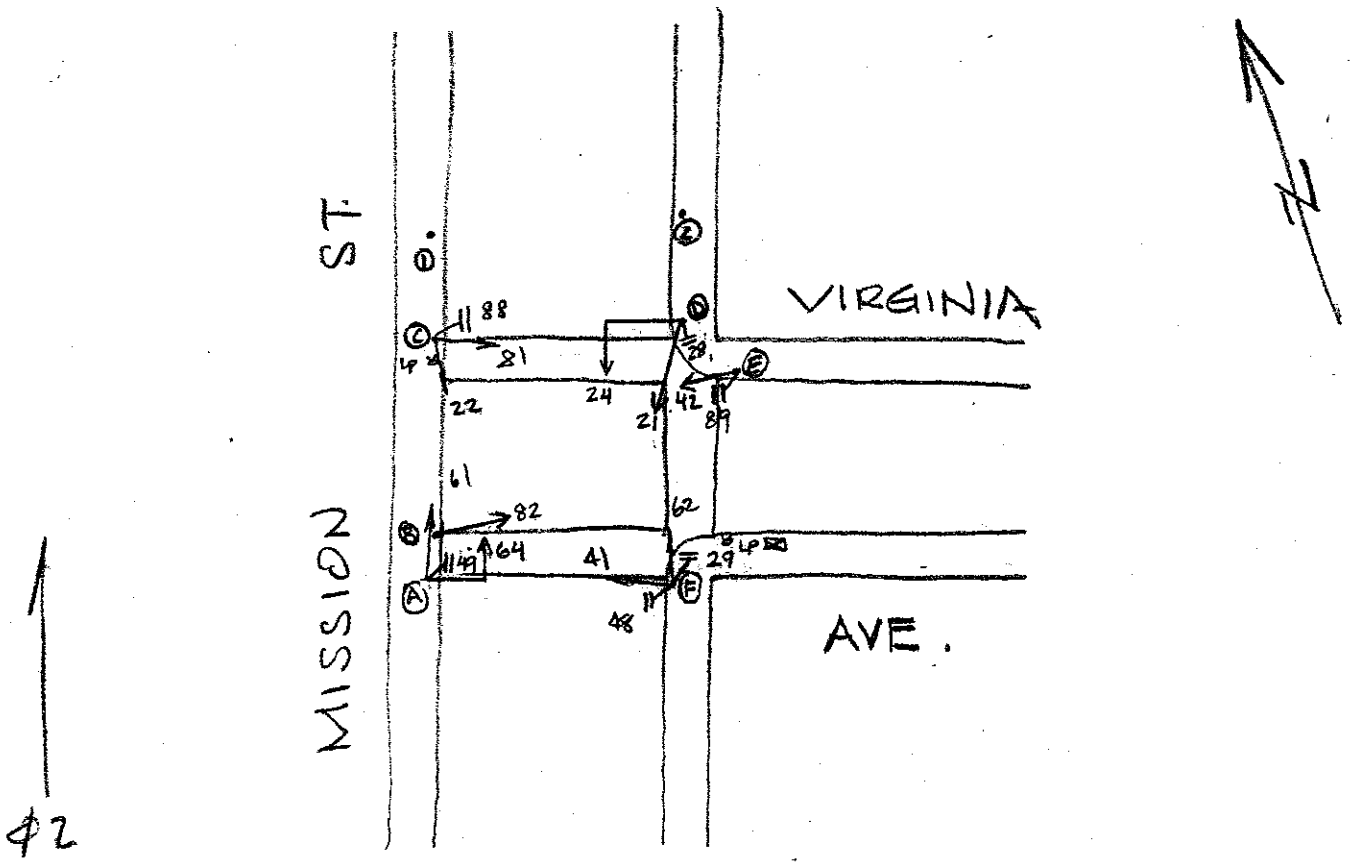

Signal Upgrade Switchover 3-31-00

POLE	FUNC.	MAT'L
A	S	S
B	M/L	S
C	S	S
D	S	S
E	L	S
F	M/L	S
1	M/L	S
2	M/L	S

SIGNAL NO.	MAKE	NO. OF SECT.	SIZE	VISOR	B.P. OR LOUVERS	MOUN'T
82	CH	3	8"	T 8"	NO	S
61	CH	3	8"	T 8"	NO	S
22	CH	3	8"	T 8"	NO	T
81	CH	3	8"	T 8"	NO	T
42	CH	1	12"R	T 12'	NO	S
21	CH	3	8"	T 8"	NO	T
62	CH	3	8"	T 8"	NO	S
41	CH	1	12"R	T 12"	NO	S
64	CH	3	12"	T 12"	BP	MAS
24	CH	3	12"	T 12"	BP	MAS

PED SIGNAL NO.	LEGEND	MESSAGE ELEMENT	MESSAGE COLOR	MAKE	MOUN'T
49	I	1S-I	W/OR	ICC	S
88	I	1S-I	W/OR	ICC	S
89	I	1S-I	W/OR	ICC	S
48	I	1S-I	W/OR	ICC	S
28	I	IS-1	W/OR	ICC	S
29	I	IS-1	W/OR	ICC	S

CONTROLLER CABINET SIZE : ORDINARY BASE CABINET: YES

COMMENTS : Upgraded signals + added mast arms