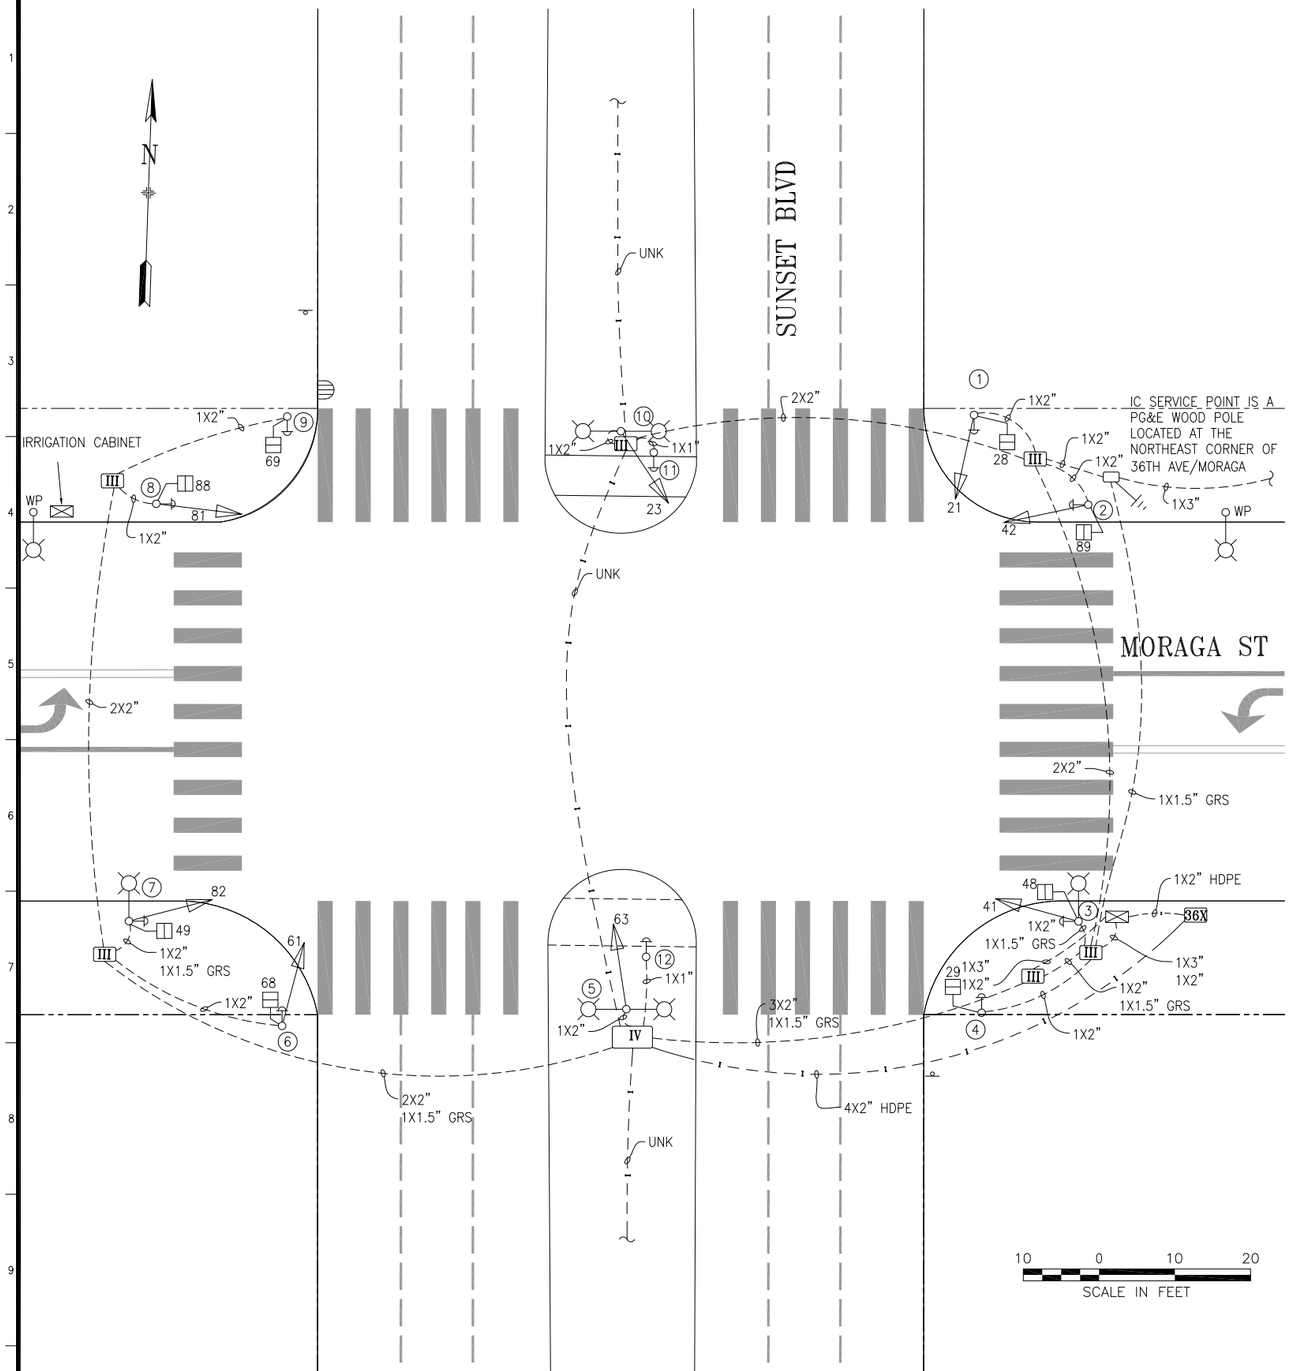

POLE AND EQUIPMENT SCHEDULE

POLE No.	TYPE OF POLE	LUMINAIRE VOLTAGE/ WATTAGE	VEHICLE SIGNAL					PEDESTRIAN SIGNAL			REMARKS
			No.	TYPE	MOUNTING	VISORS	LOUVERS	No.	TYPE	MOUNTING	
1	1-A (10')		21	3S12"	TV-1-T	T		28	1S-COUNT	SP-1	APS-2W
2	1-A (10')		42	3S12"	TV-1-T	T		89	1S-COUNT	SP-1	APS-2W
3	CITY STANDARD STREET LIGHT	150W HPS	41	3S12"	SV-1-T	T		48	1S-COUNT	SP-1	APS-2W
4	1-A (7')							29	1S-COUNT	TP-1	APS-2W
5	MARBELITE SL W/ DUAL LUMINAIRE ARMS		63	3S12"	SV-1-T	T					
6	1-A (10')		61	3S12"	TV-1-T	T		68	1S-COUNT	SP-1	APS-2W
7	CITY STANDARD STREET LIGHT	150W HPS	82	3S12"	SV-1-T	T		49	1S-COUNT	SP-1	APS-2W
8	1-A (10')		81	3S12"	TV-1-T	T		88	1S-COUNT	SP-1	APS-2W
9	1-A (7')							69	1S-COUNT	TP-1	APS-2W
10	MARBELITE SL W/ DUAL LUMINAIRE ARMS		23	3S12"	SV-1-T	T					
11	PPB POLE										APS-2W
12	PPB POLE										APS-2W

NO.	DATE	DESCRIPTION	BY	APP.
2	10/20/17	REMOVE EMPTY PPB POLE 13, PER 2821J AS-BUILT	DYeung	GDeLeon
1	11/14/16	RELOC APS FROM POLE 13 TO POLE 8. SRC 2016-295	DYeung	GDeLeon
0	3/03/16	NEW SIGNAL ACTIVATED THROUGH 2477J	D.Yeung	M.Velasco

TABLE OF REVISIONS
CHECK WITH TRACING TO SEE IF YOU HAVE LATEST REVISION

REFERENCE INFORMATION & FILE NO. OF SURVEYS

SAN FRANCISCO MUNICIPAL TRANSPORTATION AGENCY
CITY AND COUNTY OF SAN FRANCISCO

DRAWN: DATE: A.SCALES 1/11/2017
CHECKED: DATE: G.DELEON 1/13/2017

SCALE: AS SHOWN
SHEET OF SHEETS 1 OF 1

TRAFFIC SIGNAL INVENTORY DIAGRAM
MORAGA STREET AND SUNSET BOULEVARD

CNN NO. 27704000
REV NO. 2