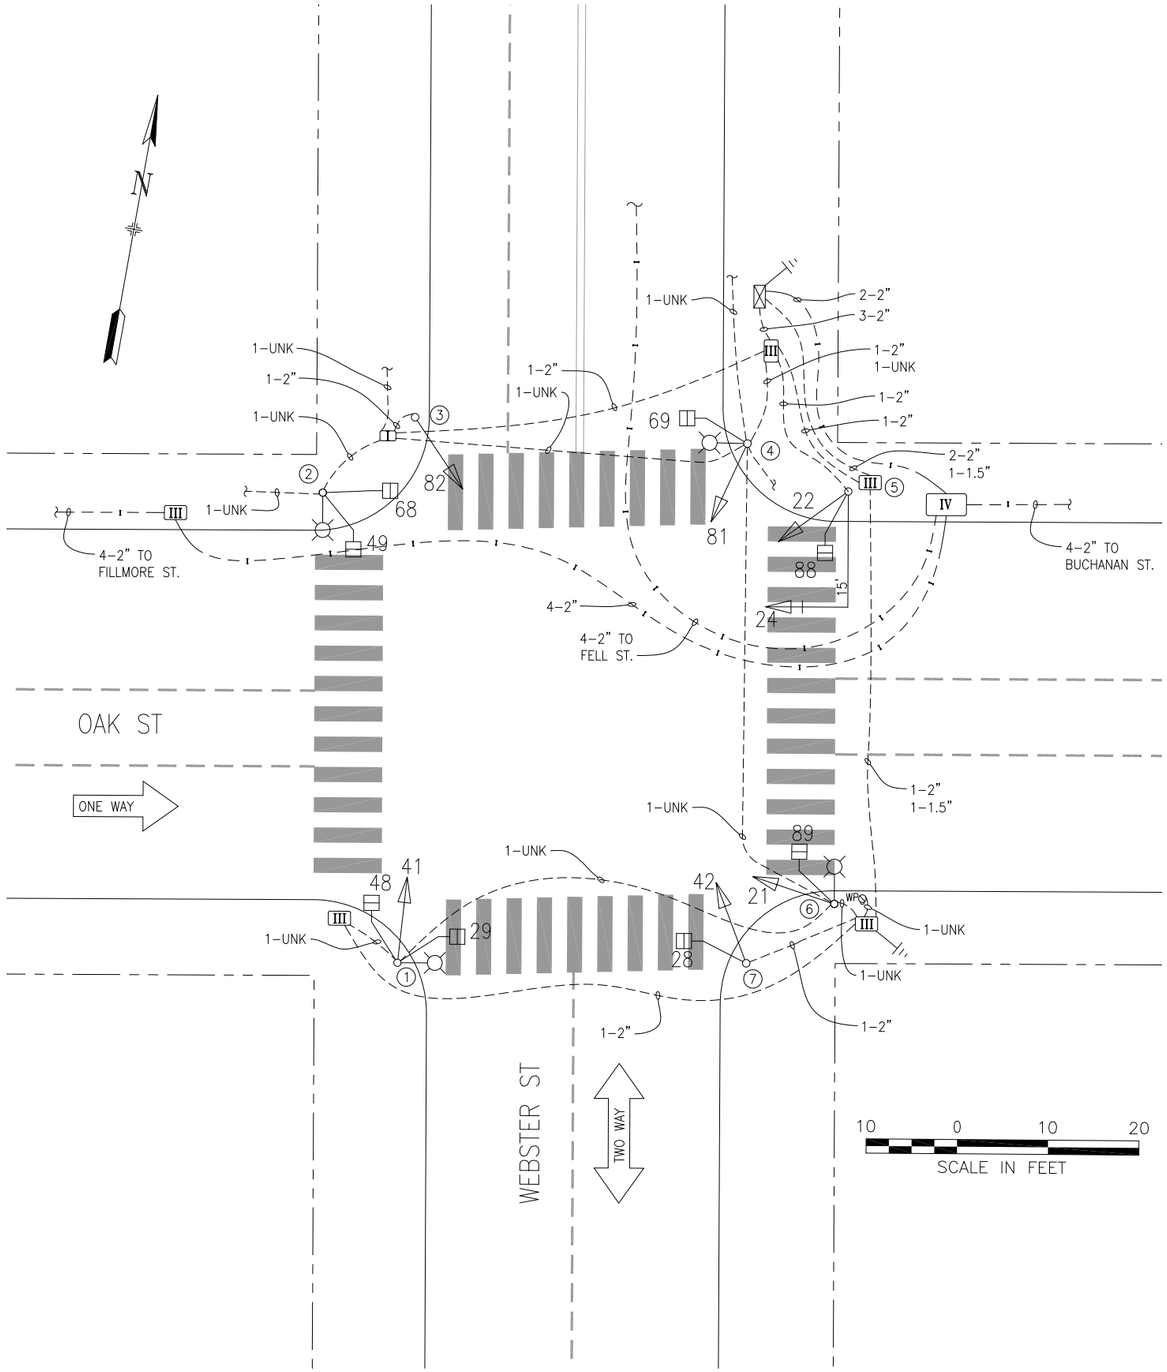

POLE AND EQUIPMENT SCHEDULE

POLE No.	TYPE OF POLE	VEHICLE SIGNAL					PEDESTRIAN SIGNAL			REMARKS
		No.	TYPE	MOUNTING	VISORS	LOUVERS	No.	TYPE	MOUNTING	
1	EXISTING STREET LIGHT	41	3S12"	SV–1–T	T		29 48	1S–COUNT 1S–COUNT	SP–1	20" NIPPLE
2	EXISTING STREET LIGHT						49 68	1S–COUNT 1S–COUNT	SP–1	
3	1–A (10')	82	3S12"	TV–1–T	T					
4	EXISTING STREET LIGHT	81	3S12"	SV–1–T	T		69	1S–COUNT	SP–1	
5	16–1–70 WITH 15' SIGNAL MAST ARM	22 24	3S12" 3S12"	SV–1–T MAS	T T		88	1S–COUNT	SP–1	BACKPLATE
6	EXISTING STREET LIGHT	21	3S12"	SV–1–T	T		89	1S–COUNT	SP–1	
7	1–A (10')	42	3S12"	TV–1–T	T		28	1S–COUNT	SP–1	

NO.	DATE	DESCRIPTION	BY	APP.
2	02/04/20	PER SRC 2019–037, CONVERTED ALL 3S8" TO 3S12"	AU	MS
1	01/10/02	SIGNAL UPGRADE BY 1660N; CONVERTED FROM AS–BUILTS	AU	MS

TABLE OF REVISIONS
CHECK WITH TRACING TO SEE IF YOU HAVE LATEST REVISION

REFERENCE INFORMATION & FILE NO. OF SURVEYS

SAN FRANCISCO MUNICIPAL TRANSPORTATION AGENCY
CITY AND COUNTY OF SAN FRANCISCO

DRAWN: AU DATE: 02/19
CHECKED: MS DATE: 02/19

SCALE: AS SHOWN
SHEET OF SHEETS

TRAFFIC SIGNAL INVENTORY DIAGRAM
OAK ST & WEBSTER ST

CNN NO. 25900000
REV NO. 1