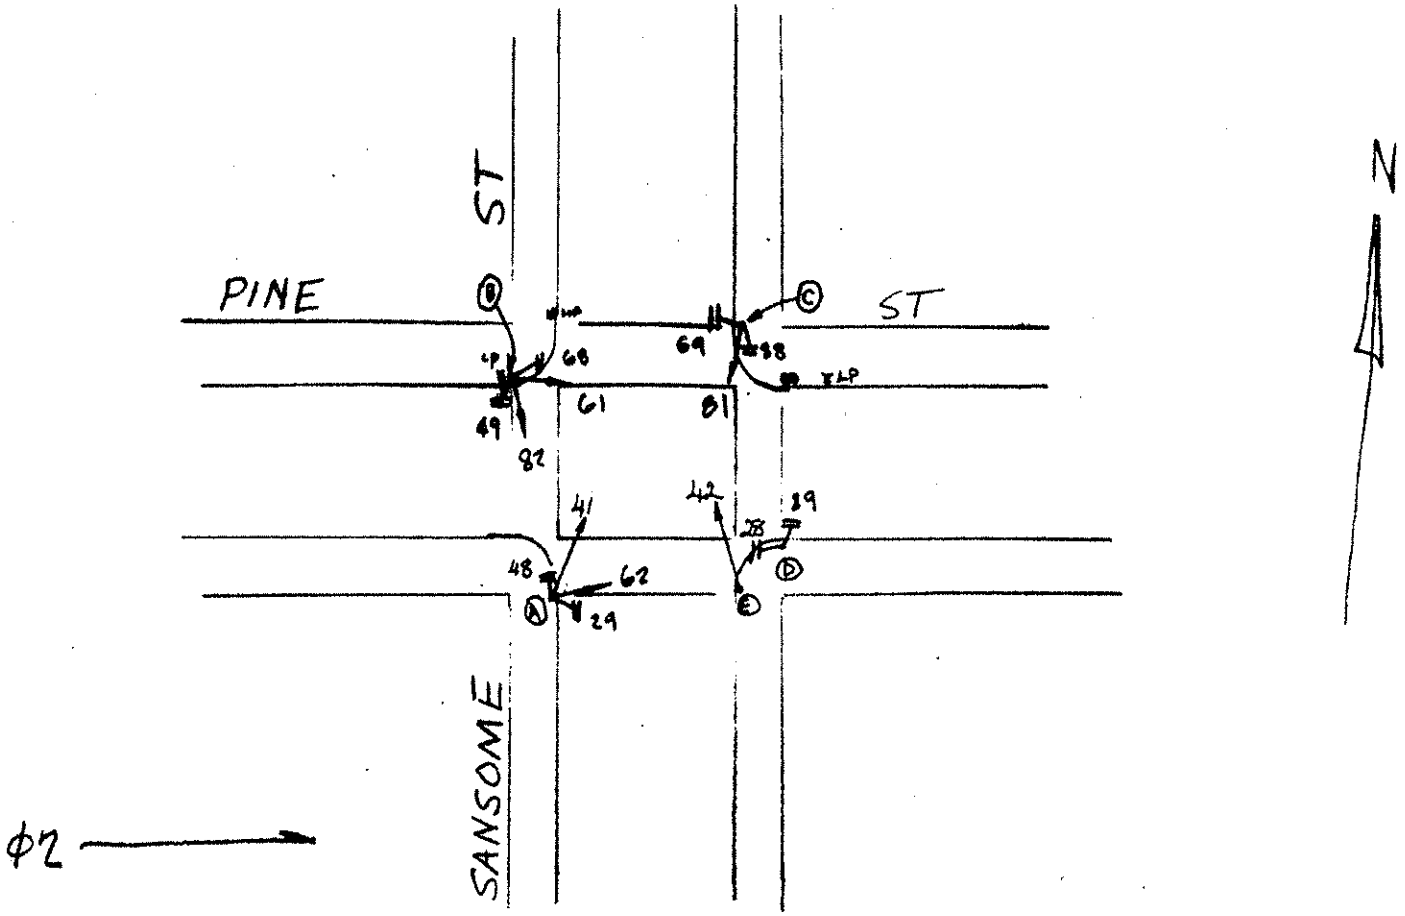

9-18-9

POLE	FUNC.	MAT'L
A	L	S
B	L	S
C	L	S
D	L	S
E	S	S

SIGNAL NO.	MAKE	NO. OF SECT.	SIZE	VISOR	B.P. OR LOUVERS	MOUN'T
62	CH	3	8"	C 12"	No	S
82	GA	3	8"	FC 12"	No	S
61	GA	3	8"	FC 12"	No	S
81	GA	3	8"	FC 12"	No	S
41	CH	3	8"	C 12"	No	S
42	TCT	3	8"	C 12"	No	T

PED SIGNAL NO.	LEGEND	MESSAGE ELEMENT	MESSAGE COLOR	MAKE	MOUN
29	I	IS-I	W/OR	ICC	S
48	I	IS-I	W/OR	ICC	S
49	I	IS-I	W/OR	ICC	S
68	I	IS-I	W/OR	ICC	S
69	I	IS-I	W/OR	ICC	S
88	I	IS-I	W/OR	ICC	S
89	I	IS-I	W/OR	ICC	S
28	I	IS-I	W/OR	ICC	S

CONTROLLER CABINET SIZE : ORDINARY BASE CABINET: NO

COMMENTS :