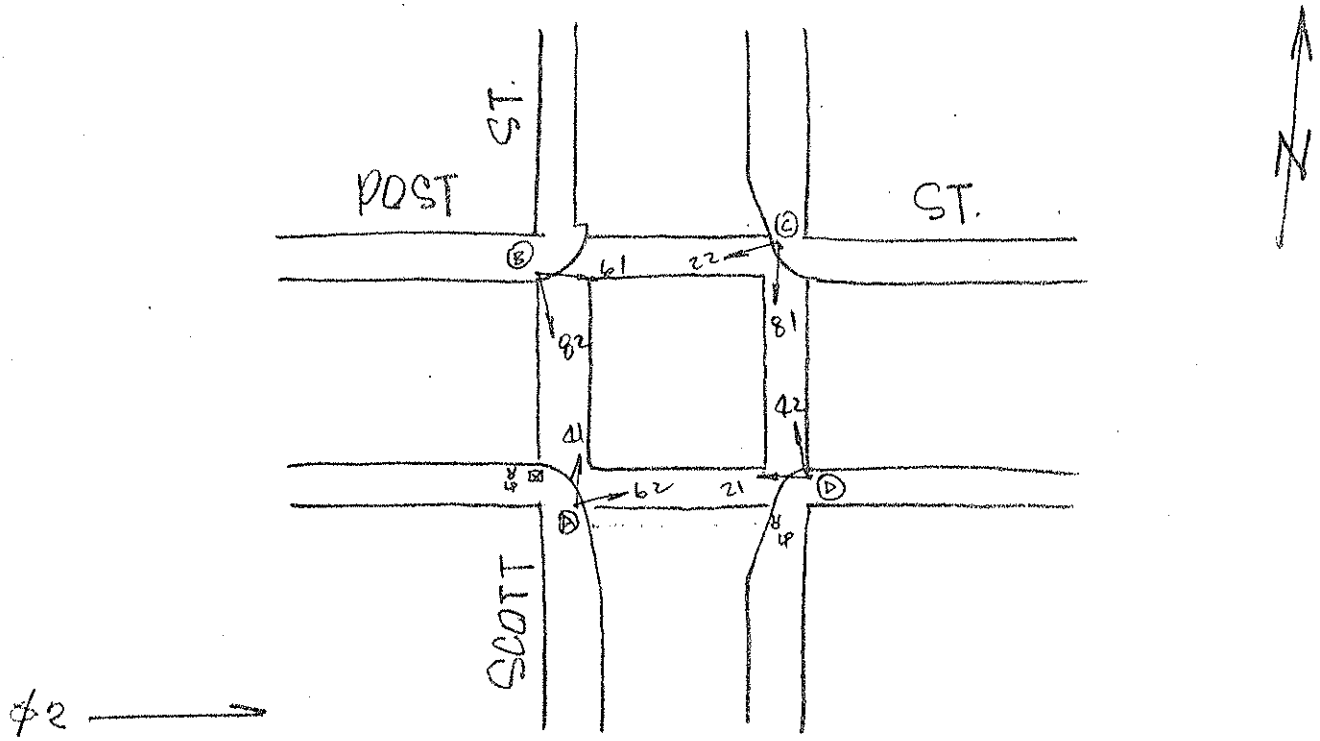

3-2-79

POLE	FUNC.	MAT'L
A	L	C
B	L	C
C	L	C
D	L	C

SIGNAL NO.	MAKE	NO. OF SECT.	SIZE	VISOR	B.P. OR LOUVERS	MOUN'T
62	EC	3	8"	FC 8"	NO	S
41	EC	3	8"	FC 8"	NO	S
82	EC	3	8"	FC 8"	NO	S
61	EC	3	8"	FC 8"	NO	S
22	EC	3	8"	FC 8"	NO	S
81	EC	3	8"	FC 8"	NO	S
42	EC	3	8"	FC 8"	NO	S
21	EC	3	8"	FC 8"	NO	S

PED SIGNAL NO.	LEGEND	MESSAGE ELEMENT	MESSAGE COLOR	MAKE	MOUN'T

CONTROLLER CABINET SIZE : ORDINARY BASE CABINET: YES

COMMENTS :