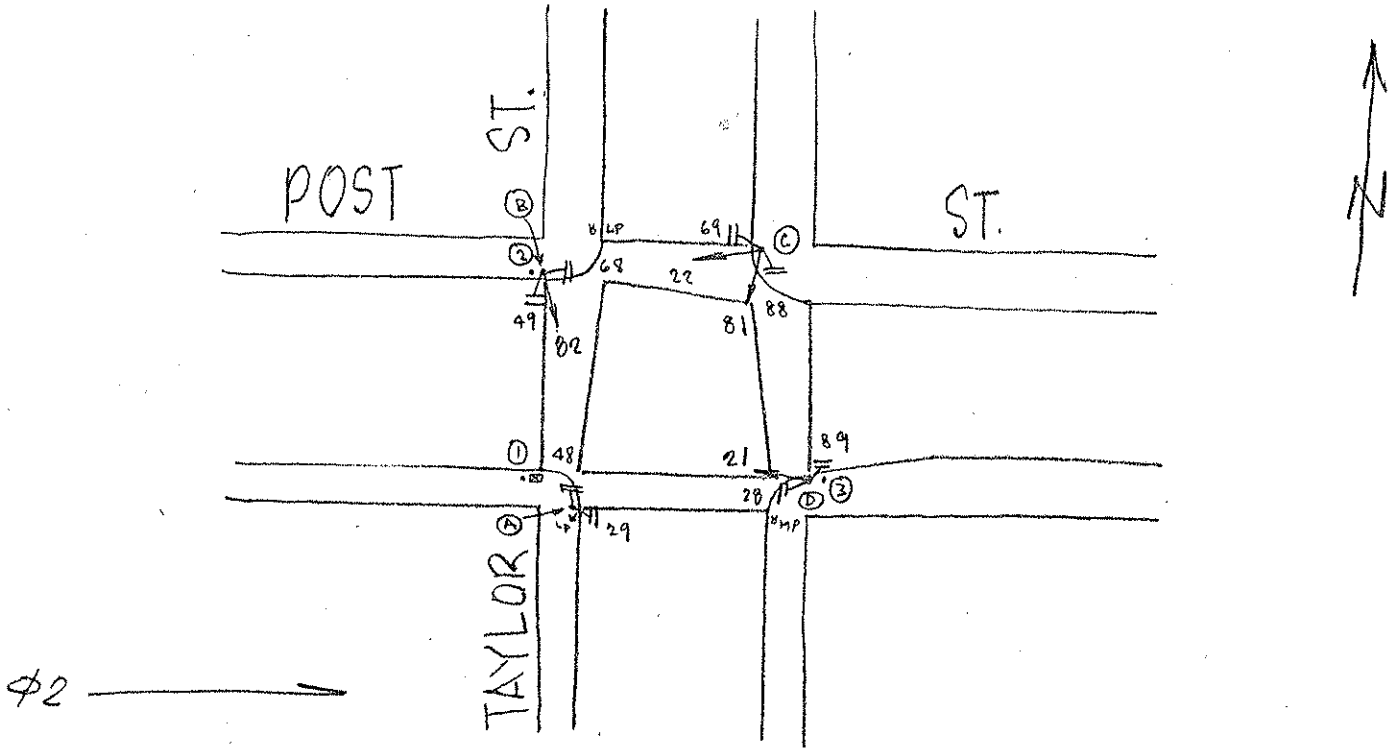

6/16/20

POLE	FUNC.	MAT'L
A	S	S
B	S	S
C	S	S
D	S	S
1	M	S
2	M	S
3	M	S

SIGNAL NO.	MAKE	NO. OF SECT.	SIZE	VISOR	B.P. OR LOUVERS	MOUN'T
82	EC	3	12"	T	NO	T
22	EC	3	12"	T	NO	T
81	EC	3	12"	T	NO	T
21	EC	3	12"	T	NO	T

PED SIGNAL NO.	LEGEND	MESSAGE ELEMENT	MESSAGE COLOR	MAKE	MOUN'T
29	W/DW	GRD	G/R	ED	T
48	W/DW	GRD	G/R	ED	T
49	W/DW	GRD	G/R	ED	S
68	W/DW	GRD	G/R	ED	S
69	W/DW	GRD	G/R	ED	S
88	W/DW	GRD	G/R	ED	S
89	W/DW	GRD	G/R	ED	S
28	W/DW	GRD	G/R	ED	S

CONTROLLER CABINET SIZE : ORDINARY BASE CABINET: NO

COMMENTS :

SRC 2020-079 completed 6/16/20
Signals 82, 22, 81, and 21 upgraded to 12" - P. Panyam