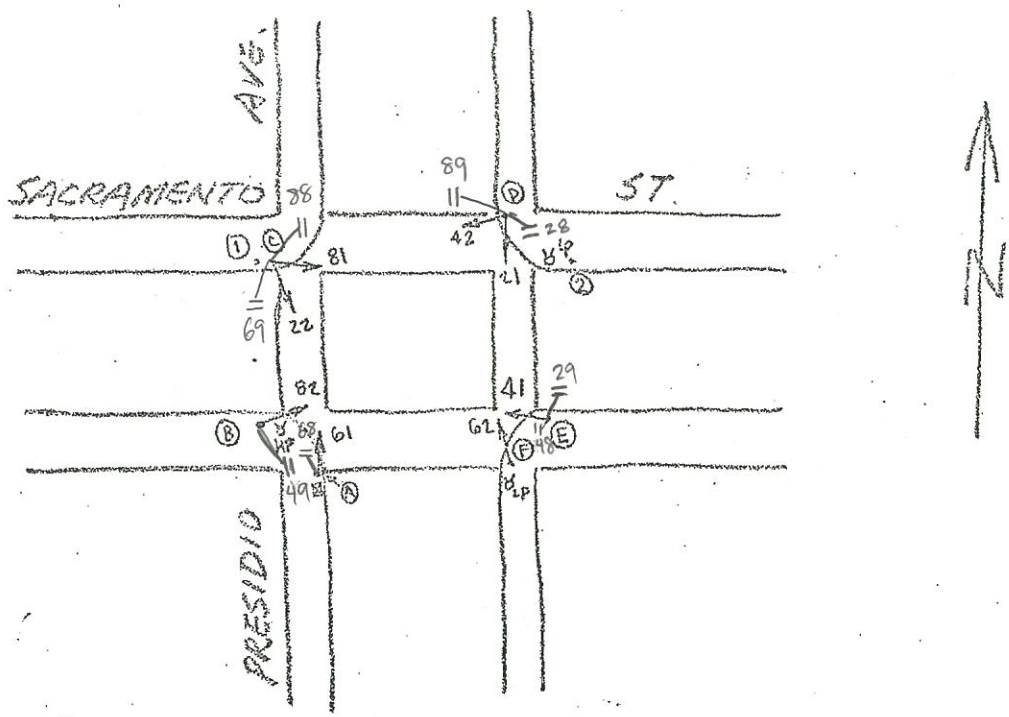

Ø2

5-31-16
1-16-79

POLE	FUNC.	MAT'L
A	M	S
B	L	S
C	S	C
D	S	C
E	S	C
F	M	S
1	M	S
2	L	S

SIGNAL NO.	MAKE	NO. OF SECT.	SIZE	VISOR	B.P. OR LOUVERS	MOUN'T
61	EC	3	8"	EC 8"	No	S
82	EC	3	8"	EC 8"	No.	S
22	EC	3	8"	EC 8"	NO	T
81	EC	3	8"	EC 8"	NO	T
42	EC	3	8"	EC 8"	NO	T
21	EC	3	8"	EC 8"	NO	T
41	GA	3	8"	EC 8"	No	T
62	EC	3	8"	EC 8"	No	S

PED SIGNAL NO.	LEGEND	MESSAGE ELEMENT	MESSAGE COLOR	MAKE	MOUN'T
68	I	LED	W/OR		S
49	I	LED	W/OR		S
69/88	I	LED	W/OR		S
28/89	I	LED	W/OR		S
29/48	I	LED	W/OR		S

CONTROLLER CABINET SIZE : ORDINARY BASE CABINET: YES

COMMENTS:

INSTALLED PEDESTRIAN SIGNALS FOR ALL CROSSINGS PER SRC # 2016-006. Activated 5/31/16 1245