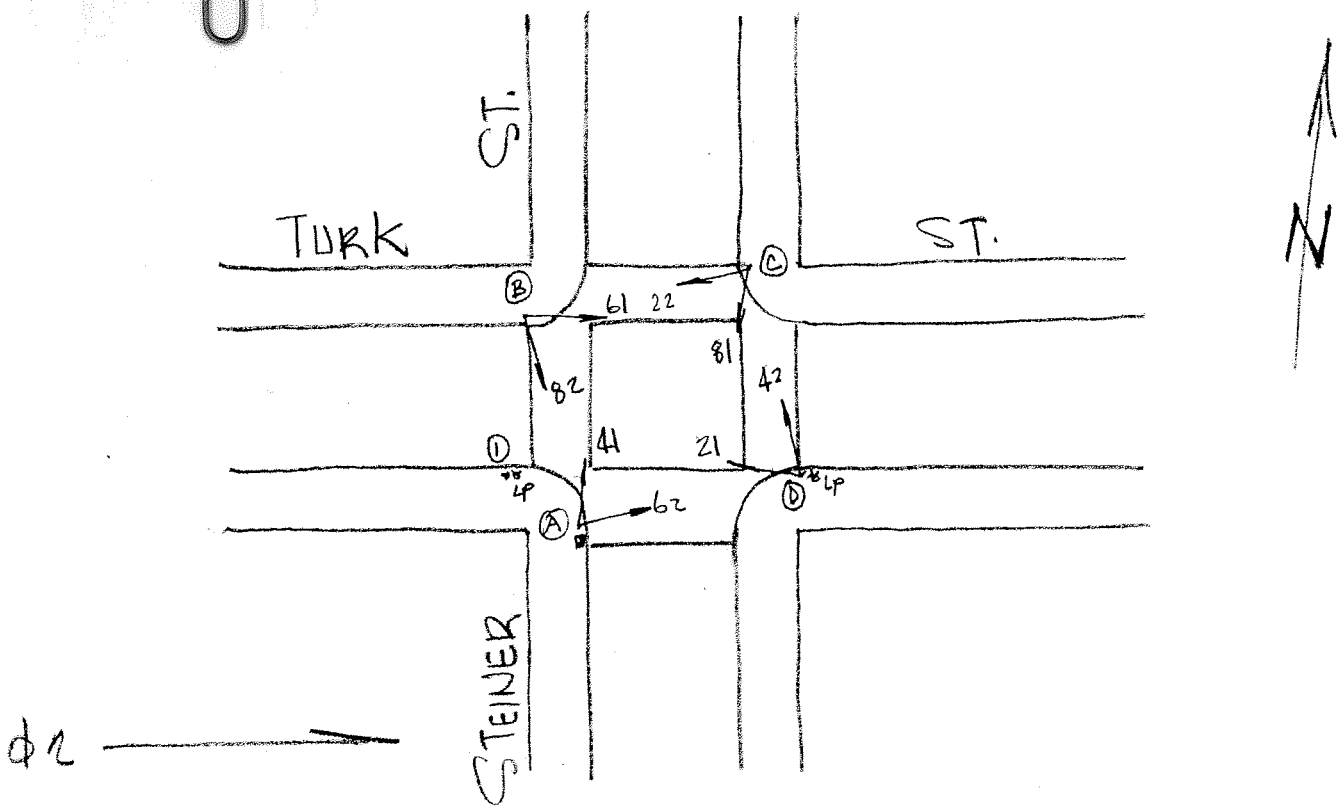

2-21-12

POLE	FUNC.	MAT'L
A	L	C
B	L	C
C	L	C
D	L	C
1	U	W

SIGNAL NO.	MAKE	NO. OF SECT.	SIZE	VISOR	B.P. OR LOUVERS	MOUN'T
62	EO	3	12"	FC 12"	NO	S
41	EO	3	12"	FC 12"	NO	S
82	EO	3	12"	FC 12"	NO	S
61	EO	3	12"	FC 12"	NO	S
22	EO	3	8"	FC 8"	NO	S
81	EO	3	8"	FC 8"	NO	S
42	EO	3	8"	FC 8"	NO	S
21	EO	3	8"	FC 8"	NO	S

PED SIGNAL NO.	LEGEND	MESSAGE ELEMENT	MESSAGE COLOR	MAKE	MOUN'T

CONTROLLER CABINET SIZE : ORDINARY BASE CABINET: NO

COMMENTS : SRC 2011-294 changed 61, 82, 41 & 62 to 12" heads 2/21/12