SUTTER & STOCKTON

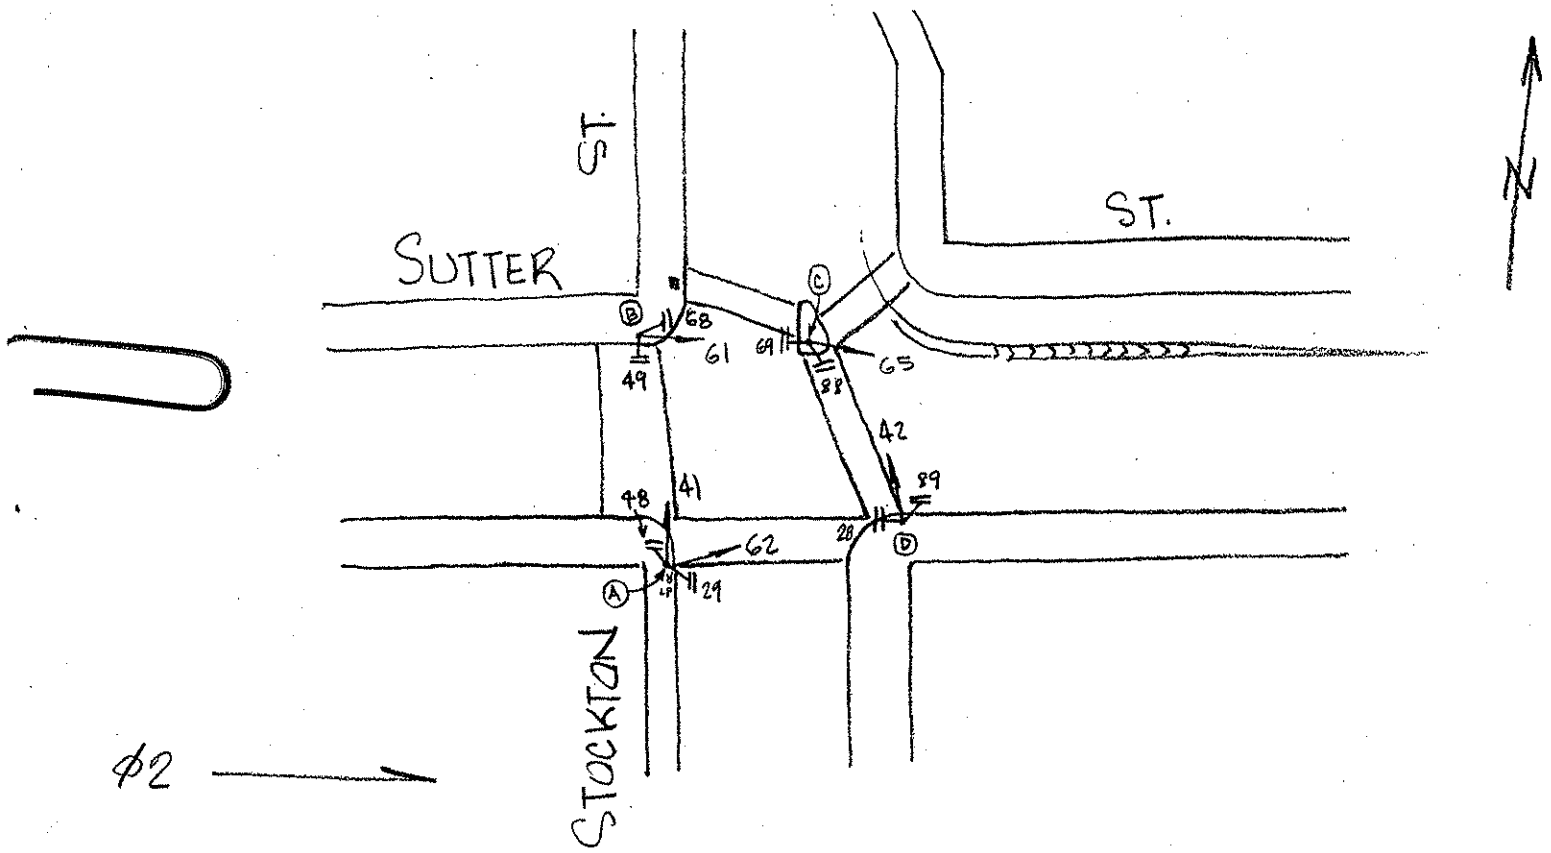

Ø2

11-93

POLE	FUNC.	MAT'L
A	M	S
B	L	O
C	S	S
D	L	O

SIGNAL NO.	MAKE	NO. OF SECT.	SIZE	VISOR	B.P. OR LOUVERS	MOUN'T
62	GA	3	8"	FC 8"	No	S
41	GA	3	8"	FC 8"	No	S
61	GA	3	8"	FC 8"	No	S
65	EO	3	8"	FC 8"	NO	T
42	GA	3	8"	FC 8"	No	S

PED SIGNAL NO.	LEGEND	MESSAGE ELEMENT	MESSAGE COLOR	MAKE	MOUN'T
29	DW/W	1S	I	ICC	S
48	DW/W	1S	I	ICC	S
49	DW/W	1S	I	ICC	S
68	DW/W	1S	I	ICC	S
69	I	1S	I	ICC	S
88	I	1S	I	ICC	S
89	DW/W	1S	I	ICC	S
28	DW/W	1S	I	ICC	S

CONTROLLER CABINET SIZE : ORDINARY BASE CABINET: NO

COMMENTS: NEW MUNI POLE A & NEW SIGNALS 29, 62, 41 & 48 WERE INSTALLED UNDER NO. 30 STOCKTON LINE CONTRACT MR-888.