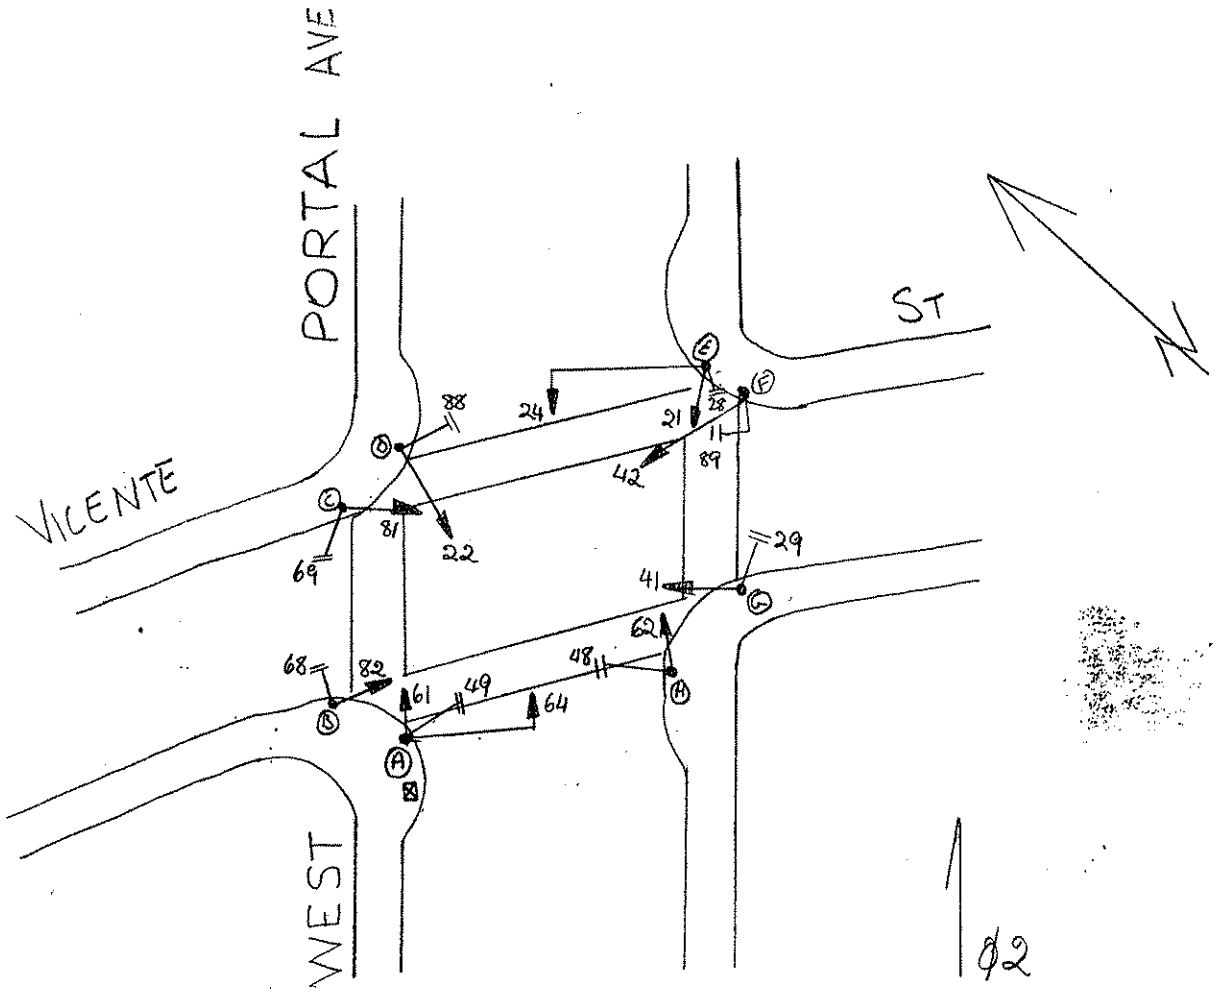


7/22/96

| POLE | FUNC. | MAT'L |
|---|---|---|
| A | S | S |
| B | S | S |
| C | S | S |
| D | S | S |
| E | S | S |
| F | S | S |
| G | S | S |
| H | S | S |
| I | S | S |

| SIGNAL NO. | MAKE | NO. OF SECT. | SIZE | VISOR | B.P. OR LOUVERS | MOUN'T |
|---|---|---|---|---|---|---|
| 61 | TCT | 3 | 8" | FC 8" | No | S |
| 64 | TCT | 3 | 12" | CAP 12" | BP | A |
| 82 | TCT | 3 | 8" | CAP 8" | No | T |
| 22 | TCT | 3 | 8" | FC 8" | No | T |
| 81 | TCT | 3 | 8 | CAP 8" | No | T |
| 24 | TCT | 3 | 12 | FC 12" | BP | A |
| 21 | TCT | 3 | 8 | FC 8" | No | S |
| 42 | TCT | 3 | 8 | FC 8" | No | T |
| 62 | TCT | 3 | 8 | CAP 8" | No | T |
| 41 | TCT | 3 | 8 | FC 8" | No | T |

| PED SIGNAL NO. | LEGEND | MESSAGE ELEMENT | MESSAGE COLOR | MAKE | MOUN'T |
|---|---|---|---|---|---|
| 28 | I | IS-I | OR/WH | ICL | S |
| 29 | I | IS-I | OR/WH | ICL | S |
| 48 | I | IS-I | OR/WH | ICL | S |
| 49 | I | IS-I | OR/WH | ICL | S |
| 68 | I | IS-I | OR/WH | ICL | S |
| 69 | I | IS-I | OR/WH | ICL | S |
| 88 | I | IS-I | OR/WH | ICL | S |
| 89 | I | IS-I | OR/WH | ICL | S |

CONTROLLER CABINET SIZE : STANDARD BASE CABINET: STANDARD

**COMMENTS**: CONTRACT 45